

MAY 16 1996

LIBER 15907 pg 740

Dec-27 95 2 5 10 30

COMMISSION

LAND CORNER RECORDATION CERTIFICATE

Filing Requirement of Act 74, Mich. P.A. 1970

For corners in Oakland (County)


Located in: Commerce Twp-Corner Code #

- 1. Public Land Survey T 2N R 8E G-5
2. Property Controlling in Section S T R
3. Miscellaneous Property in Section S T R

Compliance with ACT 345, P.A. 1990
APPROVED ON: 12-07-95 T.S
OAKLAND COUNTY REMONUMENTATION PEER GROUP COMMITTEE

Register of Deeds Stamp & File Number

- 4. Lot No. , Recorded Plat
5. Private Claims

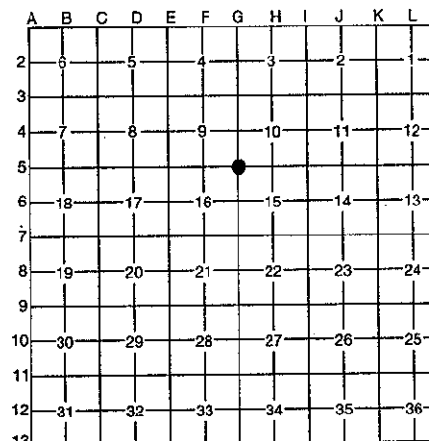

I, David Pawlaczyk, in a field survey on October 6, 1995, do hereby certify that under requirements of P.A. 74, Michigan P.A. of 1970, the corner points mentioned in lines 1 and 2 above were in conformance with regulations and rules therefore as required in the current manual of survey instructions of the United States Department of the Interior, Bureau of Land Management or by a decree of a Court of Law and/or that the corner points mentioned in lines 3, 4 and 5 above were in conformance with the rules of the Michigan Board of Professional Surveyors or by a Decree of a Court of Law; established, re-established, monumented, re-monumented, recovered, found as expressed below:

NOTE: Not more than 4 corners, all in the same town and range, may be recorded on this certificate.

A. Description of original monument and accessories and/or subsequent restoration:

Table with 6 columns: Year, Description, Monument Type, Surveyor, License #, Notes. Includes entries for 1823 Post, 1971 n/a, 1979 n/a, 1979 Found concrete monument, 1983 Found R.R. spike, 1990 Found concrete monument.

B. Description of corner evidence found and/or method applied in restoring or reestablishing corner:

A concrete monument currently occupies this corner. The following witness ties were used to verify and recover its position:

Table with 4 columns: Ties match, Survey Type, Witnesses, License #. Includes 4 ties match survey L7754 P385 and 4 ties match L.C.R.C. L7590 P40.

Field measurements were made between the following corners:

Table with 4 columns: Corner pair, Distance, Measurement type, License #. Includes F-5 to G-5 (2690.43 meas. G.L.O.), G-5 to G-6 (2655.37 meas. G.L.O.).

\$ 7.00 MISCELLANEOUS RECORDING
\$ 2.00 REMONUMENTATION
27 DEC 95 9:56 A.M. RECEIPT# 54B
PAID RECORDED - OAKLAND COUNTY
LYNN D. ALLEN, CLERK/REGISTER OF DEEDS

C. Description of monument for corner and accessories established to perpetuate locating the position of the corner:

I placed a 2" diameter brass cap stamped "Oakland County Remonumentation PS #17632" on the existing found concrete monument.

Table with 4 columns: Direction, Distance, Measurement type, Description. Includes Due N. 11.82' P.K. nail and O.C.R. tag W. face 8" Pine, Due E. 2.00' S.W. corner aluminum shed on conc. slab, S.20° W. 11.81' P.K. nail and O.C.R. tag N.W. face 10" Ash, Due W. 6.65' P.K. nail and O.C.R. tag S. face fence post, N.30° W. 10.89' P.K. nail and O.C.R. tag E. face fence post.

The selected location is accepted by me and generally accepted by Professional Surveyors as the best available evidence of the position of the original corner.

Signed by

[Signature]

Date 12-20-95

Surveyor's Michigan License No. 17632

