

MAY 16 1996

COMMISSION LAND CORNER RECORDATION CERTIFICATE
Filing Requirement of Act 74, Mich. P.A. 1970


For corners in Oakland (County) Located In: Commerce Twp. Corner Code #

- 1. Public Land Survey T2N R8E G-7
2. Property Controlling in Section S T R
3. Miscellaneous Property in Section S T R
4. Lot No. , Recorded Plat
5. Private Claims

Compliance with ACT 345, P.A. 1990
APPROVED ON: 12-07-95 T.S.
OAKLAND COUNTY REMONUMENTATION PEER GROUP COMMITTEE

Register of Deeds Stamp & File Number

I, David Pawlaczyk, in a field survey on October 4, 1995, do hereby certify that under requirements of P.A. 74, Michigan P.A. of 1970, the corner points mentioned in lines 1 and 2 above were in conformance with regulations and rules therefore as required in the current manual of survey instructions of the United States Department of the Interior, Bureau of Land Management or by a decree of a Court of Law and/or that the corner points mentioned in lines 3, 4 and 5 above were in conformance with the rules of the Michigan Board of Professional Surveyors or by a Decree of a Court of Law; established, re-established, monumented, re-monumented, recovered, found as expressed below:

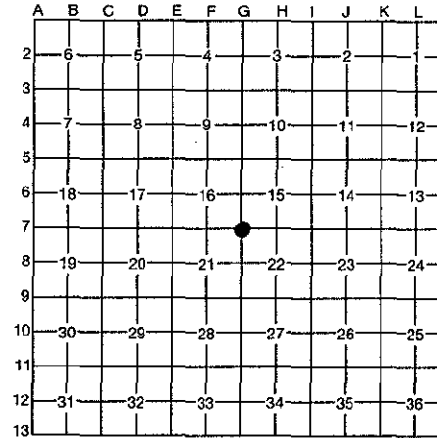

NOTE: Not more than 4 corners, all in the same town and range, may be recorded on this certificate.

A. Description of original monument and accessories and/or subsequent restoration:

Table with 5 columns: Year, Description, Surveyor, License #, Notes. Includes entries for 1823 Post, 1931 Iron pipe, 1973 Found P.K. nail, and 1992 Found P.K. nail.

RECORDED - OAKLAND COUNTY
RECEIPT# 54B
LYNN D. ALLEN, CLERK/REGISTER OF DEEDS

B. Description of corner evidence found and/or method applied in restoring or reestablishing corner:

A P.K. nail 2.0' north of the centerline of asphalt pavement currently occupies this corner. The following witness ties were used to recover and verify its position:

- 3 ties match M. Baldwin Notes 1931
3 ties match Survey Witnesses L6257 P548
3 ties match L.C.R.C. L12200, P700

Field measurements were made between the following corners:

Table with 3 columns: Corner pair, Distance, Method. Includes measurements for G-7 to F-7, G-7 to G-8, and G-7 to G-6.

C. Description of monument for corner and accessories established to perpetuate locating the position of the corner:

I replaced the found P.K. nail in asphalt pavement with a 3/4" x 24" iron rod with 2" diameter brass cap stamped "Oakland County Remonumentation PS #17632" in a new monument box.

Table with 3 columns: Bearing and Distance, Monument Description. Includes bearings like N.05° E. and descriptions like P.K. nail and O.C.R. tag.



The selected location is accepted by me and generally accepted by Professional Surveyors as the best available evidence of the position of the original corner.

Signed by [Signature] Date 12-20-95

Surveyor's Michigan License No. 17632