

COPY COMMISSION

LAND CORNER RECORDATION CERTIFICATE
Filing Requirement of Act 74, Mich. P.A. 1970

For corners in

Form with fields for location (Oakland county), corner code (G-9), and survey type (Public Land Survey, Property Controlling in Section, Miscellaneous Property in Sec.) with T/R/S indicators.

Stamp area containing recording fees (\$7.00 and \$2.00), dates (26 DEC 96), times (9:26 A.M.), and names (LYNN D. ALLEN, CLERK/REGISTER OF DEEDS). Includes 'APPROVED ON' date 11-25-96 and 'Register of Deeds Stamp & File Number'.

Fields for Lot No. and Recorded Plat.

Text block starting with 'I, James E. Kovas, in a field survey on November 25, 1996, do hereby certify that under requirements of P.A. 74, Michigan P.A. of 1970, the corner points mentioned in lines 1 and 2 above were in conformance with regulations and rules therefore as required in the current manual of survey instructions of the United States Department of the Interior, Bureau of Land Management or by a decree of a Court of Law and/or that the corner points mentioned in lines 3, 4 and 5 above were in conformance with the rules of the Michigan Board of Land Surveyors or by a Decree of a Court of Law; established, re-established, monumented, re-monumented, recovered, found as expressed below:

Grid table with columns A-M and rows 2-13. A dot is marked at the intersection of column G and row 9.

NOTE: Not more than 4 corners, all in the same town and range, may be recorded on this certificate.

A. Description of original monument and accessories and/or subsequent restoration: G-9. 1816 - G.L.O. Set Corner WIT: S31°E 2.37 Lks. Oak; S57°W 2.28 Lks. Oak; 1923 - "Spring Lake Heights" (Liber 30 Plats, Page 20) 1925 - "Wolverine Lake Manor" (Liber 38 Plats, Page 34)

Distances: G-9 to G-8 = 2640.00' (GLO); 2636.44' (Wade-Trim) G-9 to G-10 = 2640.00' (GLO); 2629.27' (Wade-Trim) G-9 to F-9 = 2640.00' (GLO); 2654.34' (Wade-Trim)

B. Description of corner evidence found and/or method applied in restoring or reestablishing corner:

G-9 Obliterated Corner- Re-established by traversing existing plat irons in the "Spring Lake Heights" Subdivision and the "Wolverine Lake Manor" Subdivision. Computed location matches existing occupation (on fence line).


WIT: SW 19.4' Fnd Plat Iron West 150.05' Fnd Plat Iron South 108.10' Fnd Plat Iron North 87.70' Fnd Plat Iron along shrub row

The Computed location was ratified by the Peer Review Committee on November 25, 1996, as the accepted corner.

C. Description of monument for corner and accessories established to perpetuate locating the position of the corner:

G-9 Set 3/4" Iron Rod with Brass Oakland Co. Remonumentation Cap # 33138 in fence line

WIT: South 2.89' Set 60d Nail/ Oakland Co. Remon Tag# 33138 E.Face U.Pole East 8.53' Set 60d Nail/ Oakland Co. Remon Tag# 33138 N.Face 8" Pine SWly 19.40' Fnd Plat Iron along Wood Fence Row

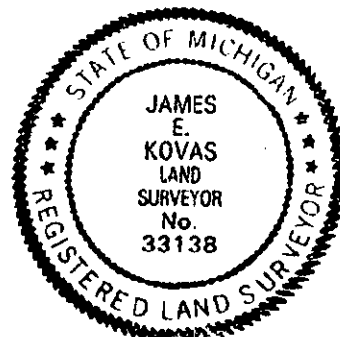

Signed by [Signature] Date December 20, 1996

Surveyor's Michigan License No. 33138

Handwritten note: 700 FILE 200