

**LAND CORNER RECORDATION CERTIFICATE**  
 Filing Requirement of Act 74, Mich. P.A. 1970

For corners in

\_\_\_\_\_ Oakland \_\_\_\_\_ Located In: \_\_\_\_\_ Corner Code # \_\_\_\_\_  
 (county)

1. Public Land Survey T 2N R 8E \_\_\_\_\_ G-10 \_\_\_\_\_  
 T \_\_\_\_\_ R \_\_\_\_\_  
 T \_\_\_\_\_ R \_\_\_\_\_  
 T \_\_\_\_\_ R \_\_\_\_\_

2. Property Controlling S \_\_\_\_\_ T \_\_\_\_\_ R \_\_\_\_\_  
 in Section S \_\_\_\_\_ T \_\_\_\_\_ R \_\_\_\_\_

3. Miscellaneous S \_\_\_\_\_ T \_\_\_\_\_ R \_\_\_\_\_  
 Property in Sec. S \_\_\_\_\_ T \_\_\_\_\_ R \_\_\_\_\_

\$ 7.00 MISCELLANEOUS RECORDING  
 \$ 2.00 REMONUMENTATION  
 26 DEC 96 9:26 A.M. RECEIPT# 7B  
 PAID RECORDED - OAKLAND COUNTY  
 LYNN D. ALLEN, CLERK/REGISTER OF DEEDS

APPROVED ON: 11-25-96 TS  
 OAKLAND COUNTY REMONUMENTATION  
 Register of Deeds Stamp & File Number

4. Lot No. \_\_\_\_\_, Recorded Plat \_\_\_\_\_

5. Private Claims \_\_\_\_\_

I, James E. Kovas, in a field survey on November 25, 1996, do hereby certify that under requirements of P.A. 74, Michigan P.A. of 1970, the corner points mentioned in lines 1 and 2 above were in conformance with regulations and rules therefore as required in the current manual of survey instructions of the United States Department of the Interior, Bureau of Land Management or by a decree of a Court of Law and/or that the corner points mentioned in lines 3, 4 and 5 above were in conformance with the rules of the Michigan Board of Land Surveyors or by a Decree of a Court of Law; established, re-established, monumented, re-monumented, recovered, found as expressed below:

	A	B	C	D	E	F	G	H	I	J	K	L	M
2	6		5		4		3		2		1		
3													
4	7		8		9		10		11		12		
5													
6	18		17		16		15		14		13		
7													
8	19		20		21		22		23		24		
9													
10	30		29		28		27		26		25		
11													
12	31		32		33		34		35		36		
13													

**NOTE: Not more than 4 corners, all in the same town and range, may be recorded on this certificate.**

**A. Description of original monument and accessories and/or subsequent restoration:**

G-10  
 1816 - G.L.O. Set 1/4 Post WIT: S31E 2.37 Lks. Oak; S57W 2.28 Lks. Oak;  
 1908 - F.A. Slater, Survey, distance listed below; 1982 - Finney & Assoc., LCRC (Liber 8140, Page 224) 1/2" Iron Rod in Monument Box WIT: S50°W 142.00' Nail NW Face 18" Tree; N60°E 103.55' Nail SE Face MBT Pole; N65°W 77.05' Center of Street Sign; 1982 - "Harrison Industrial Acres" (Liber 180 Plats, Page 224) East 1340.72' 1/2" Iron; Heil, PS# 18993, Iron in Monument Box, no accessories.

Distances: G-10 to G-9 = 2640.00' (GLO); 2629.27' (Wade-Trim)  
 G-10 to G-11 = 2640.00' (GLO); 2664.42' (Slater); 2663.45' (Wade-Trim)


**B. Description of corner evidence found and/or method applied in restoring or reestablishing corner:**

G-10 Found 1/2" Iron Rod in existing Monument Box  
 WIT: N60°E 103.68' Fnd Nail SE Face MBT Pole  
 East (along E-W 1/4 Line) 1340.42' Fnd 1/2" Iron Pipe

The 1/2" Iron found was ratified by the Peer Review Committee on November 25, 1996, as the accepted corner.

**C. Description of monument for corner and accessories established to perpetuate locating the position of the corner:**

G-10 Set 3/4" Iron Rod with Brass Oakland Co. Remonumentation Cap # 33138 in existing Monument Box  
 WIT: N55°W 120.38' Set 60d Nail/ Oakland Co. Remon Tag# 33138 SW Face, S'ly 15" Trunk, S. Maple Clump  
 S40°W 134.44' Set 60d Nail/ Oakland Co. Remon Tag# 33138 SE Face 18" R. Oak  
 S40°E 127.15' Set 60d Nail/ Oakland Co. Remon Tag# 33138 NE Face 7" Maple  
 N80°E 119.12' Set 60d Nail/ Oakland Co. Remon Tag# 33138 30" Twin Willow

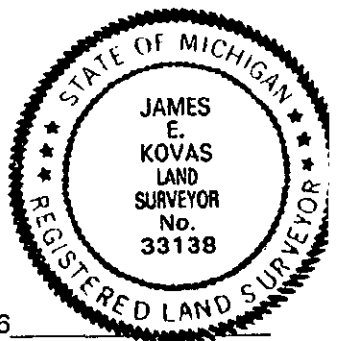

Signed by James E. Kovas Date December 20, 1996