

COPY
COMMISSION

LAND CORNER RECORDATION CERTIFICATE
Filing Requirement of Act 74, Mich. P.A. 1970

For corners in

_____ Oakland _____ (county)	Located In:	Corner Code #
1. Public Land Survey	T 2N R 8E	_____ G-11 _____
	T _____ R _____	_____
	T _____ R _____	_____
	T _____ R _____	_____
2. Property Controlling S _____ in Section	T _____ R _____	_____
	S _____ T _____ R _____	_____
3. Miscellaneous S _____ Property in Sec.	T _____ R _____	_____
	S _____ T _____ R _____	_____

\$ 7.00 MISCELLANEOUS RECORDING
 \$ 2.00 REMONUMENTATION
 26 DEC 96 9:26 A.M. RECEIPT# 7B
 PAID RECORDED - OAKLAND COUNTY
 LYNN D. ALLEN, CLERK/REGISTER OF DEEDS

Compliance with
 ACT 345, P.A. 1970
 APPROVED ON: 10-21-96 TS
 OAKLAND COUNTY REMONUMENTATION
 PEER REVIEW COMMITTEE
 Register of Deeds Stamp & File Number

4. Lot No. _____, Recorded Plat _____

5. Private Claims _____

I, James E. Kovas, in a field survey on November 25, 1996, do hereby certify that under requirements of P.A. 74, Michigan P.A. of 1970, the corner points mentioned in lines 1 and 2 above were in conformance with regulations and rules therefore as required in the current manual of survey instructions of the United States Department of the Interior, Bureau of Land Management or by a decree of a Court of Law and/or that the corner points mentioned in lines 3, 4 and 5 above were in conformance with the rules of the Michigan Board of Land Surveyors or by a Decree of a Court of Law; established, re-established, monumented, re-monumented, recovered, found as expressed below:

A	B	C	D	E	F	G	H	I	J	K	L	M
2	6	5	4	3	2	1						
3												
4	7	8	9	10	11	12						
5												
6	18	17	16	15	14	13						
7												
8	19	20	21	22	23	24						
9												
10	30	29	28	27	26	25						
11												
12	31	32	33	34	35	36						
13												

NOTE: Not more than 4 corners, all in the same town and range, may be recorded on this certificate.

A. Description of original monument and accessories and/or subsequent restoration:

G-11
 1816 - G.L.O. Set Corner WIT: S70°E 63 Lks. B.Oak; N13°W 80 Lks. Pine; 1989 - Grant Ward, PS#22445, LCRC (Liber 11176, Page 317) T-Iron WIT: S05°W 88' Spike/ Washer E.Face 10" Oak; North 32.7' Centerline of Gas Marker; West 33.89' Nail S.Face 4" Oak; 1989 - Kostecke & Assoc., T-Iron WIT: S80°E 61.1' Nail/ Cap 10" Oak; NW 103.33' P.K. Nail W.Face 30" Oak; SE 88.24' P.K. Nail E.Face 34' Twin Oak; 1993 - David P. Smith, PS#33140, LCRC (Liber 13429, Page 162) T-Iron WIT: SW 0.58' Fence Intersection; S45°E 8.3' 6" Oak; North 32.55' Centerline 4" Gas line Marker.

Distances: G-11 to F-11 = 2640.00' (GLO); 2650.23' (Wade-Trim)
 G-11 to G-12 = 2640.00' (GLO); 2632.42' (Wade-Trim)

B. Description of corner evidence found and/or method applied in restoring or reestablishing corner:

G-11 Found T-Iron at Fence Intersection (fence running South & West)

- WIT:
- North 32.70' Fnd 4" Gas line Marker
 - S80°E 61.35' Fnd Nail/ Cap 10" Oak
 - NW 103.37' Fnd P.K. Nail W.Face 30" Oak
 - SW 0.60' Fnd Fence Corner (6' high chain link)
 - S45°E 8.28' Fnd Nail 6" Oak


The T-Iron found was ratified by the Peer Review Committee on November 25, 1996, as the accepted corner.

7.00 FILE
2.00

C. Description of monument for corner and accessories established to perpetuate locating the position of the corner:

G-11 Set Concrete Monument with Brass Oakland Co. Remonumentation Cap # 33138 at location of found T-Iron

- WIT:
- North 103.31' Set 60d Nail/ Oakland Co. Remon Tag# 33138 W.Face 24" W.Oak
 - N40°E 77.00' Set 60d Nail/ Oakland Co. Remon Tag# 33138 SE Face 5" Oak
 - N40°W 110.60' Set 60d Nail/ Oakland Co. Remon Tag# 33138 SW Face 6" Maple
 - S50°E 8.40' Set 60d Nail/ Oakland Co. Remon Tag# 33138 NE Face 8" Oak

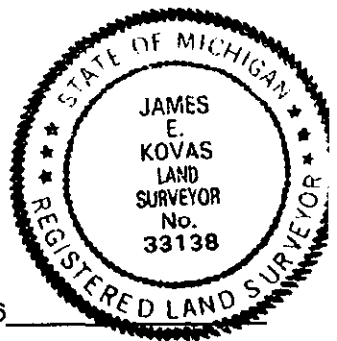

Signed by James E. Kovas Date December 20, 1996

Surveyor's Michigan License No. 33138