


MAR 11 1999

LAND CORNER RECORDATION CERTIFICATE
Filing Requirement of Act 74, Mich. P.A. 1970

For corners in SECTION

Form with fields for County (Oakland), Township (Commerce), Corner Code # (H-11), and numbered sections 1-5 for Public Land Survey, Property Controlling, Miscellaneous, Lot No., and Private Claims.

Stamp area containing recording fees: \$ 9.00 MISCELLANEOUS RECORDING, \$ 2.00 REMONUMENTATION, date 6 NOV 98 10:00 A.M., and signatures of G. WILLIAM CARDELL.

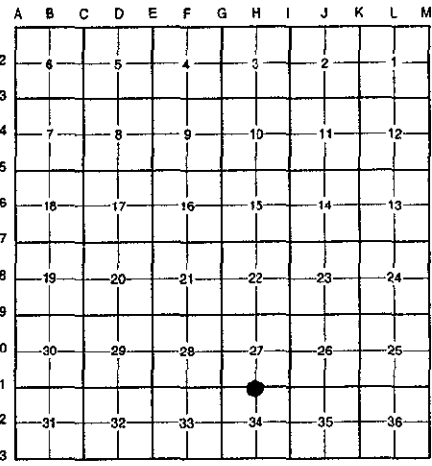

I, Randy Kolehouse, in a field survey on January 29 19 98, do hereby certify that under requirements of P.A. 74 Michigan P.A. of 1970, the corner points mentioned in lines 1 and 2 above were in conformance with regulations and rules therefore as required in the current manual of survey instructions of the United States Department of the interior, Bureau of Land Management or by a decree of a Court of Law and/or that the corner points mentioned in lines 3, 4 and 5 above were in conformance with the rules of the Michigan Board of Land Surveyors or by a Decree of a Court of Law; established, re-established, monumented, re-monumented, recovered, found as expressed below:

NOTE: Not more than 4 corners, all in the same town and range, may be recorded on this certificate.

A. Description of original monument and accessories and/or subsequent restoration:

Table with 4 columns: H-11, 1823, Wampler, G.L.O. Notes, Survey, O.C. Tax Maps, Set Post, N/A, N/A.

B. Description of corner evidence found and/or method applied in restoring or reestablishing corner:

H-11 No point recovered. Corner falls in Mud Lake. Reestablished H-11 using survey prepared by Milletics dated 1/23/87 and revised 9/10/87. Found iron at the South 1/8 corner (on centerline of Ladd Road), Southwest 1/4, Section 27 and Oakland County Monument at G-11. Measure between corners = 1331.97', Record = 1331.87', extended line East 1336.61' per Milletics survey point falls in Mud Lake. Set reference monument 914.44' West of I-11. This point is 1754.15' East of G-11.

Handwritten note: 9 00, 2 00

Measure East 2682.20' to I-11 (G.L.O. = 2669.04')
Measure West 2668.58' to G-11 (G.L.O. = 2669.04') Survey by Milletics = 2668.58'; Tax Map = 2661'.

C. Description of monument for corner and accessories established to perpetuate locating the position of the corner:


- H-11 Set a 4" concrete monument with brass cap stamped "Oakland County Remonumentation P.S. #25854".
PK Nail & Tag Stamped "Oakland Co. Remonumentation P.S. #25854" in NE Face 10" Wood Gate Post S 25° E 10.55'
PK Nail & Tag Stamped "Oakland Co. Remonumentation P.S. #25854" in NE Corner Frame Barn S 15° E 56.60'
PK Nail & Tag Stamped "Oakland Co. Remonumentation P.S. #25854" in NW Face Wood Fence Post S 50° W 13.30'
3/8" Rebar on C/L Bit. Road N 85° W 422.20' ±

The selected location is accepted by the Contractor and is generally accepted by professional surveyors as the best available evidence of the position of the original corner.

Signed by Randy J. Kolehouse, EARTH TECH

Date 9-1-98

Surveyor's Michigan License No. 25854

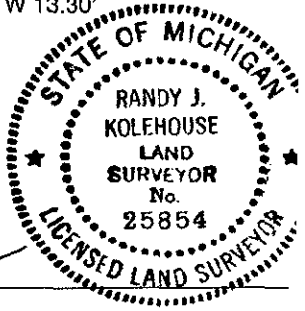

LIBER 19142PG305

SURVEY &
REMONUMENTATION

MAR 11 1999

SECTION

