

MAR 11 1999

NO-698323801

LAND CORNER RECORDATION CERTIFICATE  
Filing Requirement of Act 74, Mich. P.A. 1970

SECTION  
For corners in

<u>Oakland</u> (County)	Located in: Commerce Township	Corner Code #
1. Public Land Survey	T <u>2N</u> R <u>8E</u>	<u>1-8</u>
	T _____ R _____	_____
	T _____ R _____	_____
	T _____ R _____	_____
2. Property Controlling in Section	S _____ T _____ R _____	_____
	S _____ T _____ R _____	_____
3. Miscellaneous Property in Sec.	S _____ T _____ R _____	_____
	S _____ T _____ R _____	_____

\$ 9.00 MISCELLANEOUS RECORDING  
 \$ 2.00 REMONUMENTATION  
 6 NOV 98 10:00 AM 1998 RECEIPT# 28A  
 PAID  
 APPROVED ON: \_\_\_\_\_  
 CLERK/REGISTER OF DEEDS  
 REGISTER OF DEEDS STAMP & FILE NUMBER

- 4. Lot No. \_\_\_\_\_, Recorded Plat \_\_\_\_\_
- 5. Private Claims \_\_\_\_\_

I, Randy Kolehouse, in a field survey on August 13 19 97, do hereby certify that under requirements of P.A. 74 Michigan P.A. of 1970, the corner points mentioned in lines 1 and 2 above were in conformance with regulations and rules therefore as required in the current manual of survey instructions of the United States Department of the interior, Bureau of Land Management or by a decree of a Court of Law and/or that the corner points mentioned in lines 3, 4 and 5 above were in conformance with the rules of the Michigan Board of Land Surveyors or by a Decree of a Court of Law; established, re-established, monumented, re-monumented, recovered, found as expressed below:

A	B	C	D	E	F	G	H	I	J	K	L	M
2	6	5	4	3	2	1						
3												
4	7	8	9	10	11	12						
5												
6	18	17	16	15	14	13						
7												
8	19	20	21	22	23	24						
9												
10	30	29	28	27	26	25						
11												
12	31	32	33	34	35	36						
13												

NOTE: Not more than 4 corners, all in the same town and range, may be recorded on this certificate.

A. Description of original monument and accessories and/or subsequent restoration:

I-8	1823	Wampler	G.L.O. Notes	Set Post
	1922	Barnett	Stuart's Oak Island Sub.	N/A
	1952	MacNutt	Tampa Shores Sub. L. 64 P. 33	N/A

(Continued on Back)

B. Description of corner evidence found and/or method applied in restoring or reestablishing corner:

I-8 Found 1/2" rebar on the North right-of-way line of Glengary Road per Tampa Shores Sub. L. 64 P. 332.5' North of the North edge of Glengary Road (bit.) running East and West and 90' ± East of a tree and brush row running South to Wolverine Lake. Checks witnesses O.C.R.C. 1962 and Cert. Survey 1989 by Stevenson.

O.C.R.C. 1962	Cert. Survey 1989 (by Stevenson)
12" Oak North 15.52' (m. 15.62')	North 15.7' (m. 15.62') 24" Oak
18" Oak Northeast 20.5' (m. 21.6')	N 45° E 21.0' (m. 21.6') 24" Oak
	S 10° W 82.85' (m. 82.8') 14" Walnut


900 FILE  
2ND

Measure North 2622.8' to I-7 (G.L.O. = 2640.0')  
 Measure South 2645.15' to I-9 (G.L.O. = 2640.0')

C. Description of monument for corner and accessories established to perpetuate locating the position of the corner:

I-8 Replaced 1/2" rebar with a 5/8" x 24" rebar with brass cap stamped "Oakland County Remonumentation P.S. #25854."

- PK Nail & Tag Stamped "Oakland Co. Remonumentation P.S. #25854" in SE Side 24" Oak Stump N 55° E 21.60'
- PK Nail & Tag Stamped "Oakland Co. Remonumentation P.S. #25854" in SW Side 22" Oak N 05° E 15.62'
- PK Nail & Tag Stamped "Oakland Co. Remonumentation P.S. #25854" in SW Side 10" Ash N 58° W 25.01'
- PK Nail & Tag Stamped "Oakland Co. Remonumentation P.S. #25854" in W Side 18" Walnut S 15° W 82.80'

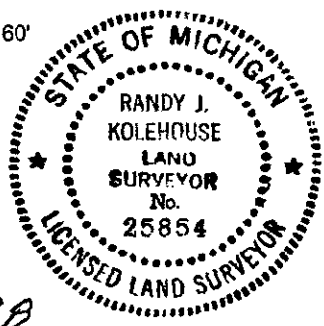

The selected location is accepted by the Contractor and is generally accepted by professional surveyors as the best available evidence of the position of the original corner.

Signed by Randy J. Kolehouse

Date 9-29-98

Surveyor's Michigan License No. 25854

LIBER 19142PG307

A. Description of original monument and accessories and/or subsequent restoration:

I-8	1962	N/A	O.C.R.C. Section Corner Witnesses No. 97	1/2" Iron Bar
	1969	Feldhauser	Tampa Shores Sub. No. 2 L. 128 P. 1	N/A
	1976	Carnahan	Cert. Survey L. 6615 P. 706	Iron Rerod
	1977	Neumann	Cert. Survey L. 7160 P. 680	N/A
	1978	Hunt	Commerce Pines Sub. L. 167 P. 24-25	N/A
	1980	Finney	Survey	N/A
	1981.	Feldhauser	Commerce Pines Sub. No. 2 L. 180 P. 9-10	N/A
	1989	Stevenson	Survey	1/2" Iron Rod
	1990	D. Smith	Lake Breeze Condominium L. 11751 P. 144-146	N/A
	N/A	N/A	O.C. Tax Maps	N/A

SURVEY &  
REMONUMENTATION

MAR 11 1999

SECTION