

MAR 11 1999

LAND CORNER RECORDATION CERTIFICATE

Filing Requirement of Act 74, Mich. P.A. 1970 \$ 7.00 MISCELLANEOUS RECORDING

For corners in SECTION

Oakland (County)

Located in: Commerce Township Corner Code #

Table with 4 columns: Item, Township, Range, Section. Row 1: Public Land Survey, T 2N, R 8E, I-11.

\$ 2.00 REMONUMENTATION 6 NOV 98 10:00 A.M. RECEIPT# 28A PAID G. WILLIAM CADWELL CLERK/REGISTER OF DEEDS Compliance with ACT 345, P.A. 1990 APPROVED ON: 05-06-98 JS OAKLAND COUNTY REMONUMENTATION PEER GROUP COMMITTEE Register of Deeds Stamp & File Number

4. Lot No. , Recorded Plat 5. Private Claims

I, Randy Kolehouse, in a field survey on November 4 19 97, do hereby certify that under requirements of P.A. 74 Michigan P.A. of 1970, the corner points mentioned in lines 1 and 2 above were in conformance with regulations and rules therefore as required in the current manual of survey instructions of the United States Department of the Interior, Bureau of Land Management or by a decree of a Court of Law and/or that the corner points mentioned in lines 3, 4 and 5 above were in conformance with the rules of the Michigan Board of Land Surveyors or by a Decree of a Court of Law; established, re-established, monumented, re-monumented, recovered, found as expressed below:


NOTE: Not more than 4 corners, all in the same town and range, may be recorded on this certificate.

A. Description of original monument and accessories and/or subsequent restoration:

Table with 4 columns: Item, Date, Description, Status. Row 1: I-11 1817 Wampler G.L.O. Notes Set Post.

B. Description of corner evidence found and/or method applied in restoring or reestablishing corner:

I-11 Found a "T" iron with a Consumers Power Co. Cap along side a 1/2" iron pipe on line of a tree row and an old downed fence running East and West. Extended the North line of Schoolcraft Manor Sub. East line hits "T" iron 0.10' +/- . Measuring East from Northeast corner of subdivision checks within 0.3' +/- . Accepted "T" iron as the corner.

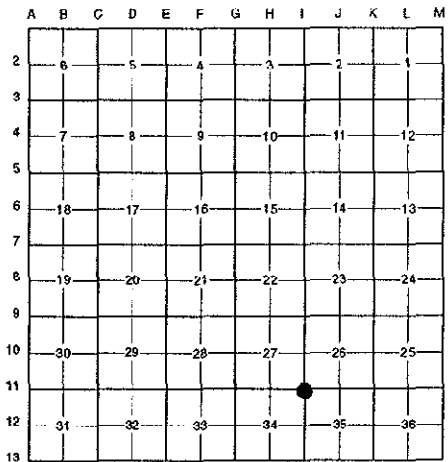

Measure North 2640.92' to I-10 (G.L.O. = 2640.00') Measure South 2602.50' to I-12 (G.L.O. = 2640.00') Measure East 2642.28' to J-11 (G.L.O. = 2656.50') Measure West 2682.20' to H-11 (G.L.O. = 2669.04')

C. Description of monument for corner and accessories established to perpetuate locating the position of the corner:

I-11 Replaced "T" iron with a 5/8" x 24" rebar with brass cap stamped "Oakland County Remonumentation P.S. #25854."

- PK Nail & Tag Stamped "Oakland Co. Remonumentation P.S. #25854" in S'ly Face 18" Hickory N 85° E 7.23'
- PK Nail & Tag Stamped "Oakland Co. Remonumentation P.S. #25854" in W'ly Face 10" Elm S 08° E 52.46'
- PK Nail & Tag Stamped "Oakland Co. Remonumentation P.S. #25854" in W'ly Face 6" Elm S 11° W 56.61'
- PK Nail & Tag Stamped "Oakland Co. Remonumentation P.S. #25854" in W'ly Face 10" Oak N 76° W 13.98'

The selected location is accepted by the Contractor and is generally accepted by professional surveyors as the best available evidence of the position of the original corner.

Signed by Randy J. Kolehouse Date Aug 3, 1998 Surveyor's Michigan License No. 25854

7.00 2.00

