

MAR 11 1999

LAND CORNER RECORDATION CERTIFICATE
Filing Requirement of Act 74, Mich. P.A. 1970

For corners in SECTION

Table with columns: Located in: Commerce Township, Corner Code #, and rows for Public Land Survey, Property Controlling in Section, and Miscellaneous Property in Sec.

Stamp area containing recording fees (\$7.00 MISCELLANEOUS RECORDING, \$2.00 REMONUMENTATION), date (6 NOV 20 1998), and signatures of Randy J. Kolehouse and Clerk.

4. Lot No. _____, Recorded Plat _____
5. Private Claims _____

I, Randy Kolehouse, in a field survey on November 1 19 97, do hereby certify that under requirements of P.A. 74 Michigan P.A. of 1970, the corner points mentioned in lines 1 and 2 above were in conformance with regulations and rules therefore as required in the current manual of survey instructions of the United States Department of the Interior, Bureau of Land Management or by a decree of a Court of Law and/or that the corner points mentioned in lines 3, 4 and 5 above were in conformance with the rules of the Michigan Board of Land Surveyors or by a Decree of a Court of Law; established, re-established, monumented, re-monumented, recovered, found as expressed below:

NOTE: Not more than 4 corners, all in the same town and range, may be recorded on this certificate.

A. Description of original monument and accessories and/or subsequent restoration:

Table with columns: Lot No., Description, G.L.O. Notes, and Set Post. Includes entries for 1823 Wampler, 1955 Tri-A Sub. L. 76 P. 4, and N/A O.C. Tax Maps.

B. Description of corner evidence found and/or method applied in restoring or reestablishing corner:

I-12 Found a 1/2" iron rod in a 4" diameter concrete monument at the Southwest corner of Lot #10, Tri-A Sub. L. 76 P. 4. Found no other information on record for this corner. The found concrete monument checks Tri-A Subdivision. Accepted found concrete monument as the corner.


Measure North 2602.48' to I-11 (G.L.O. = 2640.0') (Tri-A Sub. = 2602.62')
Did not measure South as corner falls in Walled Lake.

C. Description of monument for corner and accessories established to perpetuate locating the position of the corner:

- I-12 Set a brass cap stamped "Oakland County Remonumentation P.S. #25854" on an existing concrete monument.
PK Nail & Tag Stamped "Oakland Co. Remonumentation P.S. #25854" in SW'ly Face P. Pole N 75° E 1.49'
PK Nail & Tag Stamped "Oakland Co. Remonumentation P.S. #25854" in E'ly Face 12" Maple S 10° E 13.59'
PK Nail & Tag Stamped "Oakland Co. Remonumentation P.S. #25854" in SE'ly Face 6" Maple S 40° W 13.17'
PK Nail & Tag Stamped "Oakland Co. Remonumentation P.S. #25854" in Twin 6" Poplar N 27° W 37.25'
SW Corner of Shed of House #471 N 56° E 70.77'

The selected location is accepted by the Contractor and is generally accepted by professional surveyors as the best available evidence of the position of the original corner.

Signed by Randy J. Kolehouse Date Aug 3, 1998
Surveyor's Michigan License No. 25854

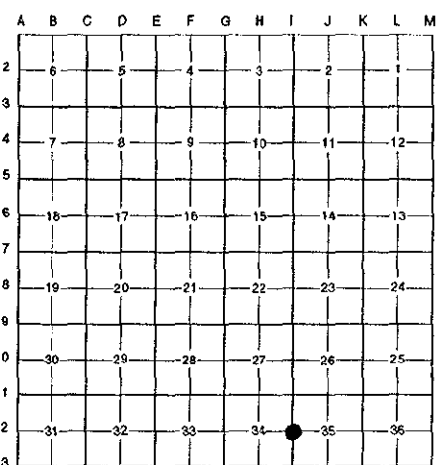

Handwritten notes: 700, 200, 2

