

MAR 11 1999

LAND CORNER RECORDATION CERTIFICATE
Filing Requirement of Act 74, Mich. P.A. 1970

For corners in SECTION
Oakland (County)

Located in: Commerce Corner Code #
Township

Table with 4 columns: Item, Township (T), Range (R), and Corner Code #. Includes items like Public Land Survey, Property Controlling in Section, etc.

\$ 7.00 MISCELLANEOUS RECORDING
\$ 2.00 REMONUMENTATION
6 NOV 98 10:01 A.M. RECEIPT# 28A
PAID RECORDED - OAKLAND COUNTY
G. WILLIAM CADDELL
CLERK/REGISTER OF DEEDS
APPROVED ON: 05-06-98 JS
OAKLAND COUNTY REMONUMENTATION PEER GROUP COMMITTEE
Register of Deeds Stamp & File Number

4. Lot No. , Recorded Plat
5. Private Claims

I, Randy Kolehouse, in a field survey on January 15 19 98, do hereby certify that under requirements of P.A. 74 Michigan P.A. of 1970, the corner points mentioned in lines 1 and 2 above were in conformance with regulations and rules therefore as required in the current manual of survey instructions of the United States Department of the interior, Bureau of Land Management or by a decree of a Court of Law and/or that the corner points mentioned in lines 3, 4 and 5 above were in conformance with the rules of the Michigan Board of Land Surveyors or by a Decree of a Court of Law; established, re-established, monumented, re-monumented, recovered, found as expressed below:

NOTE: Not more than 4 corners, all in the same town and range, may be recorded on this certificate.

A. Description of original monument and accessories and/or subsequent restoration:

Table with 4 columns: Item, Description, G.L.O. Notes, Set Post. Includes entries for Wampler, Kostecke, Kovas, etc.

Records indicate this corner is not common with J-13, T3N, R8E.

B. Description of corner evidence found and/or method applied in restoring or reestablishing corner:

J-1 Found a 4" diameter monument with a 1/2" iron rod and Oakland County Remon. Cap #33138. This corner was set by Wade-Trim, Inc., as a reference monument 170.79' West of J-13, T3N, R8E.


Measure East 2538.97' to Calculated Location of K-1
Measure West 2916.52' to I-1 (G.L.O. = 2640.0')

C. Description of monument for corner and accessories established to perpetuate locating the position of the corner:

- J-1 1/2" rebar in a 4" concrete monument with brass cap stamped "Oakland County Remonumentation P.S. #33138."
PK Nail & Tag Stamped "Oakland Co. Remonumentation P.S. #33138" in E Side 7" Box Elder N 36° E 14.53'
PK Nail & Tag Stamped "Oakland Co. Remonumentation P.S. #33138" in E Side 7" Poplar S 37° E 6.81'
PK Nail & Tag Stamped "Oakland Co. Remonumentation P.S. #33138" in N Side 12" Box Elder West 6.88'
PK Nail & Tag Stamped "Oakland Co. Remonumentation P.S. #33138" in S Side 12" Box Elder N 53° W 21.33'

The selected location is accepted by the Contractor and is generally accepted by professional surveyors as the best available evidence of the position of the original corner.

Signed by Randy Kolehouse Date 9-1-98
EARTH TECH
Surveyor's Michigan License No. 25854

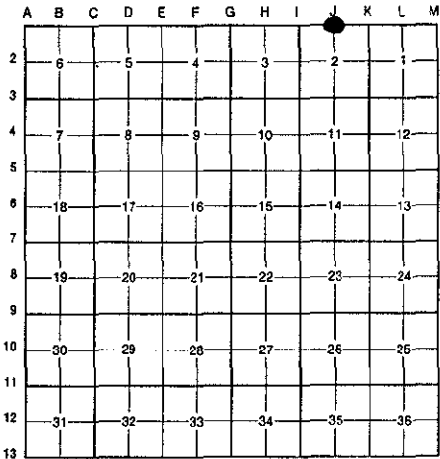

Handwritten initials 'JK' and '200'.

