

MAR 11 1999

LIBER 19142 PG 315

LAND CORNER RECORDATION CERTIFICATE
Filing Requirement of Act 74, Mich. P.A. 1970

SECTION

For corners in

Oakland (County)

Located in: Commerce Township Corner Code #

Table with 4 columns: Item, Township, Range, Section. Row 1: Public Land Survey, T 2N, R 8E, J-9. Row 2: Property Controlling in Section, S, T, R. Row 3: Miscellaneous Property in Sec., S, T, R.

- 4. Lot No. , Recorded Plat
5. Private Claims

\$ 9.00 MISCELLANEOUS RECORDING
\$ 2.00 REMONUMENTATION
6 NOV 98 10:01 A.M. RECEIPT# 2886
PAID RECORDED - OAKLAND COUNTY
G. WILLIAM CADDELL
CLERK/REGISTER OF DEEDS
Compliance with
ACT 345, P.A. 1990
APPROVED ON: 05-06-98 JS
OAKLAND COUNTY REMONUMENTATION
PEER GROUP COMMITTEE
Register of Deeds Stamp & File Number

I, Randy Kolehouse, in a field survey on August 12 19 97, do hereby certify that under requirements of P.A. 74 Michigan P.A. of 1970, the corner points mentioned in lines 1 and 2 above were in conformance with regulations and rules therefore as required in the current manual of survey instructions of the United States Department of the interior, Bureau of Land Management or by a decree of a Court of Law and/or that the corner points mentioned in lines 3, 4 and 5 above were in conformance with the rules of the Michigan Board of Land Surveyors or by a Decree of a Court of Law; established, re-established, monumented, re-monumented, recovered, found as expressed below:

NOTE: Not more than 4 corners, all in the same town and range, may be recorded on this certificate.

A. Description of original monument and accessories and/or subsequent restoration:

Table with 4 columns: Corner Code, Year, Name, Notes. Row 1: J-9, 1823, Wampler, G.L.O. Notes, Set Post. Row 2: 1955, Gillespie, Hill 'N Dale Village Sub. L. 82 P. 33-35, N/A. Row 3: 1958, McAlpine, Decker Heights Sub. L. 95 P. 15, N/A.

(Continued on Back)

B. Description of corner evidence found and/or method applied in restoring or reestablishing corner:

J-9 Found a 1/2" rebar 50' ± East of the C/L of Decker Road (bit.) running West to South and 25' ± North of the C/L of Meadow Ridge Road (bit.) running East. The location of this rebar is approximately 0.3' North and 0.3' East per monumentation found in Decker Heights Sub. but checks good with Hill N' Dale Village. Accepted 1/2" rebar as the corner. Also checks the following witnesses:

Cert. Survey L. 10747 P. 817
N 40° E 27.01 PK NW Side Sign Post
S 30° E 46.27' PK W Side 22" Basswood

Measure East 2666.82' to K-9 (G.L.O. = 2663.10')
Measure West 2670.97' to I-9 (G.L.O. = 2663.10') (L.C.R.C. L 5979 P. 325 = 2663.57')

C. Description of monument for corner and accessories established to perpetuate locating the position of the corner:

J-9 Replaced 1/2" rebar with a 4" x 36" concrete monument with a 1/2" rebar with brass cap stamped "Oakland County Remonumentation P.S. #25854."

PK Nail & Tag Stamped "Oakland Co. Remonumentation P.S. #25854" in NW Side Wood Sign Post N 40° E 27.01'
PK Nail & Tag Stamped "Oakland Co. Remonumentation P.S. #25854" in W Side 22" Basswood S 30° E 46.27'
PK Nail & Tag Stamped "Oakland Co. Remonumentation P.S. #25854" in SW Side 16" Oak S 70° W 111.87'
PK Nail & Tag Stamped "Oakland Co. Remonumentation P.S. #25854" in NW Face Light Pole Southeast 60.27'


The selected location is accepted by the Contractor and is generally accepted by professional surveyors as the best available evidence of the position of the original corner.

Signed by Randy J Kolehouse

Date 9-25-98

EARTH TECH

Surveyor's Michigan License No. 25854

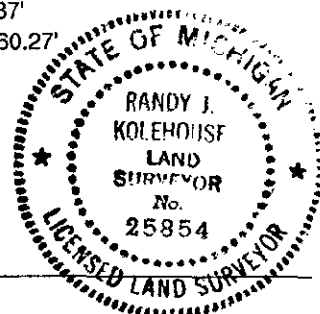

Grid table with columns A-M and rows 2-13. Contains numerical values for each cell, likely representing a survey grid or coordinate system.

500 FILE
200

Liber 19142 Pg 315.1

SURVEY &
REMONUMENTATION

MAR 11 1999

SECTION

A. Description of original monument and accessories and/or subsequent restoration:

J-9	1961	McAlpine	Decker Heights Sub. No. 2 L. 104 P. 14	N/A
	1962	N/A	O.C.R.C. Section Corner Witnesses No. 115	1/2" x 29" Steel Rod
	1962	N/A	O.C.R.C. Section Corner Witnesses No. 115	1/2" x 39" Rod
	1972	Kattouah	L.C.R.C. L. 5979 P. 325-326	Set Iron Pipe
	1974	Kattouah	Cert. Survey L. 8331? P. 497	N/A
	1974	Kattouah	Cert. Survey L. 8331? P. 498	1/2" Iron Pipe
	1988	Kapelczak	Cert. Survey L. 10747 P. 817	1" Square Bolt
	1989	Kapelczak	Survey	1/2" Iron Rod
	1991	Roskelly	Survey	N/A
	N/A	N/A	O.C. Tax Maps	N/A