

**SURVEY & REMONUMENTATION**

Mar 10 95 040427

MAY - 1 1995

LIBER 15288 PG 513

**COMMISSION**

**LAND CORNER RECORDATION CERTIFICATE** 7.00 MISC RECORDING CHG - IN HOUSE  
 Filing Requirement of Act 74, Mich. P.A. 1970 2.00 REMON CHG - IN HOUSE

For corners in Oakland

Commerce Twp.

10 MAR 95 4:02 P.M. RECEIPT# 177B  
 PAID RECORDED - OAKLAND COUNTY  
 LYNN D. ALLEN, CLERK/REGISTER OF DEEDS  
 Compliance with  
 ACT 345, P.A. 1990

	Located In:		Corner Code #
	2N	8E	
1. Public Land Survey	T	R	J-13
	T	R	
	T	R	
	T	R	
2. Property Controlling in Section	S	T	R
	S	T	R
3. Miscellaneous Property in Sec.	S	T	R
	S	T	R

APPROVED ON: 12-5-94  
 OAKLAND COUNTY REMONUMENTATION  
 PEER GROUP COMMITTEE

**OK - T. SMITH**

Register of Deeds Stamp & File Number

- 4. Lot No. \_\_\_\_\_, Recorded Plat \_\_\_\_\_
- 5. Private Claims \_\_\_\_\_

David Pawlaczyk November 30 94

I, \_\_\_\_\_, in a field survey on \_\_\_\_\_, 19 \_\_\_\_\_, do hereby certify that under requirements of P.A. 74, Michigan P.A. of 1970, the corner points mentioned in lines 1 and 2 above were in conformance with regulations and rules therefore as required in the current manual of survey instructions of the United States Department of the Interior, Bureau of Land Management or by a decree of a Court of Law and/or that the corner points mentioned in lines 3, 4 and 5 above were in conformance with the rules of the Michigan Board of Land Surveyors or by a Decree of a Court of Law; established, re-established, monumented, re-monumented, recovered, found as expressed below.

A	B	C	D	E	F	G	H	I	J	K	L	M
2	6	5	4	3	2	1						
3												
4	7	8	9	10	11	12						
5												
6	18	17	16	15	14	13						
7												
8	19	20	21	22	23	24						
9												
10	30	29	28	27	26	25						
11												
12	31	32	33	34	35	36						
13												

**NOTE: Not more than 4 corners, all in the same town and range, may be recorded on this certificate.**

**A. Description of original monument and accessories and/or subsequent restoration:**

	G.L.O.	A. Holmes	N/A	Notes
1815 Post				
1989 1/2" re-rod	L.C.R.C.	R. Higgins	#21570	L11041 P606

**B. Description of corner evidence found and/or method applied in restoring or reestablishing corner:**

A 1/2" iron rod in a monument box in asphalt pavement currently occupies this corner. The following witness ties were used to recover and verify its present position:  
 3 ties from L.C.R.C. L11041 P606 match the existing iron in monument box.

Field measurements were made between the following corners:

	meas.	G.L.O.	Notes
J-13 to K-13	2650.82		
	2640.00	rec.	
	2650.89	rec.	Condo. O.C.C.P. 800


**C. Description of monument for corner and accessories established to perpetuate locating the position of the corner:**

I placed a 2" diameter brass cap on the existing 1/2" iron rod in an existing monument box in asphalt pavement.

N.50° W.	57.40'	P.K. nail and O.C.R. tag in S.W. face D.E. pole
N.36° E.	68.21'	P.K. nail and O.C.R. tag in S.E. face Twin 16" Poplar
S.70° E.	103.86'	P.K. nail and O.C.R. tag in N.E. face MBT pole
S.68° W.	97.16'	P.K. nail and O.C.R. tag in N.W. face MBT pole
West	263.24'	1/2" Iron rod in monument box

The selected location is accepted by me and generally accepted by Professional Surveyors as the best available evidence of the position of the original corner.

7.00  
2.00

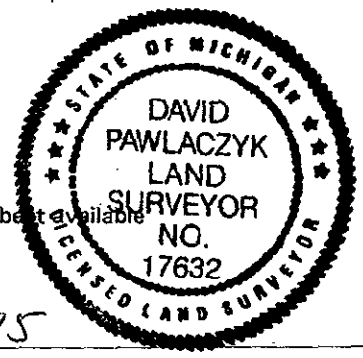

Signed by [Signature]  
 17632

Date 2-16-95

Surveyor's Michigan License No. \_\_\_\_\_