

SURVEY & REMONUMENTATION

LIBER 19142PC317

MAR 11 1999

LAND CORNER RECORDATION CERTIFICATE Filing Requirement of Act 74, Mich. P.A. 1970 \$ 7.00 MISCELLANEOUS RECORDING \$ 2.00 REMONUMENTATION

For corners in SECTION Oakland (County)

Located in: Commerce Township Corner Code #

Table with 3 columns: Item, Township (T/S), and Corner Code (R/K). Includes Public Land Survey, Property Controlling, and Miscellaneous Property in Sec.

6 NOV 98 10:02 A.M. RECEIPT# 28A PAID RECORDED - OAKLAND COUNTY G. WILLIAM CADDELL CLERK/REGISTER OF DEEDS

Compliance with ACT 345, P.A. 1990 APPROVED ON: 05-06-98 JS OAKLAND COUNTY REMONUMENTATION PEER GROUP COMMITTEE

Register of Deeds Stamp & File Number

- 4. Lot No. Recorded Plat 5. Private Claims

I, Randy Kolehouse, in a field survey on December 11 19 97, do hereby certify that under requirements of P.A. 74 Michigan P.A. of 1970, the corner points mentioned in lines 1 and 2 above were in conformance with regulations and rules therefore as required in the current manual of survey instructions of the United States Department of the interior, Bureau of Land Management or by a decree of a Court of Law and/or that the corner points mentioned in lines 3, 4 and 5 above were in conformance with the rules of the Michigan Board of Land Surveyors or by a Decree of a Court of Law; established, re-established, monumented, re-monumented, recovered, found as expressed below:


NOTE: Not more than 4 corners, all in the same town and range, may be recorded on this certificate.

A. Description of original monument and accessories and/or subsequent restoration:

Table with 4 columns: Corner Code, Year, Name, Description, and Set Post. Lists monuments like Wampler, Zeimet, Kapelczak, and O.C. Tax Maps.

B. Description of corner evidence found and/or method applied in restoring or reestablishing corner:

K-3 Found a 1/2" iron rod in a 4" diameter concrete monument 150' ± South of War Bonnet cul de sac. This corner checks very closely to Golf Manor Sub. No. 3 L. 100 P. 28 and Morey's Manor Sub. L. 88 P. 9. Measured East to Southwest corner of Morey's Manor Sub. R-1349.2' Measured 1349.78'. Checked deflector angle at Southwest corner Morey's Manor Sub. R-174° 40' 30" Calculated 174° 38' 38" East-North-West. This corner also checks Woods Edge Estates Condo.

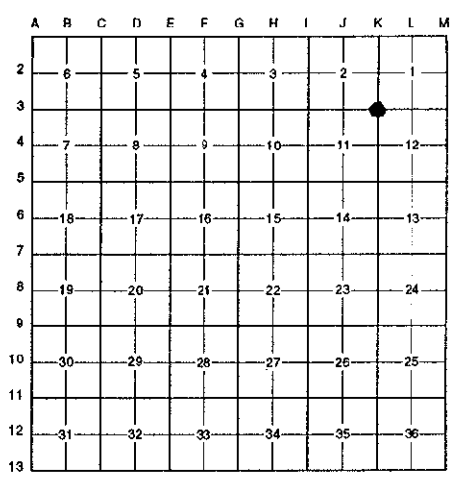

Measure North 2689.10' to K-2 (G.L.O. = 2640.0') Measure South 2646.72' to K-4 (G.L.O. = 2640.0') Measure East 2699.56' to L-3 (G.L.O. = 2699.4') Measure West 2717.50' to J-3 (G.L.O. = 2689.5')

C. Description of monument for corner and accessories established to perpetuate locating the position of the corner:

- K-3 Placed brass cap stamped "Oakland County Remonumentation P.S. #25854" on an existing concrete monument. PK Nail & Tag Stamped "Oakland Co. Remonumentation P.S. #25854" in Twin 8" & 10" Cherry S 40° W 21.956' PK Nail & Tag Stamped "Oakland Co. Remonumentation P.S. #25854" in 20" Black Oak N 50° W 16.91' PK Nail & Tag Stamped "Oakland Co. Remonumentation P.S. #25854" in 6" Oak N 20° E 25.85' PK Nail & Tag Stamped "Oakland Co. Remonumentation P.S. #25854" in 10" Oak S 17° E 39.03'

The selected location is accepted by the Contractor and is generally accepted by professional surveyors as the best available evidence of the position of the original corner.

Signed by Randy Kolehouse Date Aug 3, 1998 EARTH TECH Surveyor's Michigan License No. 25854

700 200

