

MAR 11 1999

LAND CORNER RECORDATION CERTIFICATE
Filing Requirement of Act 74, Mich. P.A. 1970


110-69832381

For corners in SECTION

Located in:	Commerce Township	Corner Code #
1. Public Land Survey	T 2N R 8E	M-6
	T R	
	T R	
	T R	
2. Property Controlling in Section	S T R	
	S T R	
3. Miscellaneous Property in Sec.	S T R	
	S T R	
4. Lot No. _____, Recorded Plat _____		
5. Private Claims _____		

\$ 7.00 MISCELLANEOUS RECORDING
 \$ 2.00 REMONUMENTATION
 6 NOV 98 10:03 A.M. RECEIPT# 28A
 ACT 74, P.A. 1970
 APPROVED ON: 05 RECORDED - OAKLAND COUNTY
 OAKLAND COUNTY REMONUMENTATION
 CLERK/REGISTER OF DEEDS
 Register of Deeds Stamp & File Number

I, Randy Kolehouse, in a field survey on November 20 19 97, do hereby certify that under requirements of P.A. 74 Michigan P.A. of 1970, the corner points mentioned in lines 1 and 2 above were in conformance with regulations and rules therefore as required in the current manual of survey instructions of the United States Department of the interior, Bureau of Land Management or by a decree of a Court of Law and/or that the corner points mentioned in lines 3, 4 and 5 above were in conformance with the rules of the Michigan Board of Land Surveyors or by a Decree of a Court of Law; established, re-established, monumented, re-monumented, recovered, found as expressed below:

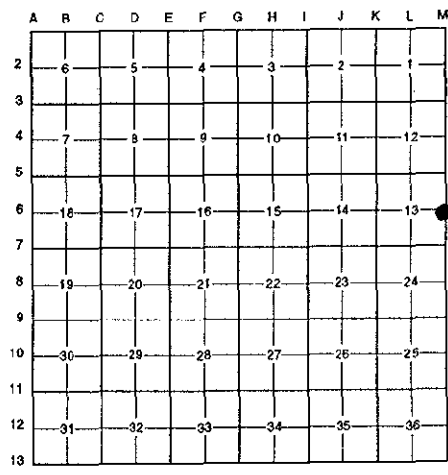

NOTE: Not more than 4 corners, all in the same town and range, may be recorded on this certificate.

A. Description of original monument and accessories and/or subsequent restoration:

M-6	1816	Holmes	G.L.O. Notes	Set Post
	1962	N/A	O.C.R.C. Section Corner Witnesses No. 92	N/A
	1973	McMahon	Cert. Survey 6201 P. 888-889	N/A
	1994	N/A	O.C.R.C. Richardson Road Project #42751	N/A
	N/A	N/A	O.C. Tax Maps	N/A

Records indicate this corner is not common with A-6, T2N, R9E.

B. Description of corner evidence found and/or method applied in restoring or reestablishing corner:

M-6 Established corner using O.C.R.C. Survey Plan for Richardson Road Sheet No. "1" of 1, Project No. 42751, dated 6/10/94 (382.80' North of A-6, T2N, R9E) using recorded angle at A-6 of 179° 32' 25" S-E-N. This point falls 6' +/- East of the east edge of pavement of Woodland Drive.

Measure South 2624.77' to M-7 (G.L.O. = 2640.0') (O.C.R.C. = 2624.27') (Cert. Survey L. 6201 P. 888 = 2640.00').
 Did not measure North as M-5 falls in Middle Straits Lake.

C. Description of monument for corner and accessories established to perpetuate locating the position of the corner:

- M-6 Set a concrete monument with brass cap stamped "Oakland County Remonumentation P.S. #25854."
- PK Nail & Tag Stamped "Oakland Co. Remonumentation P.S. #25854" in W'ly Face 32" Oak N 11° E 70.09'
- PK Nail & Tag Stamped "Oakland Co. Remonumentation P.S. #25854" in NW'ly Face 13" Oak N 49° E 52.28'
- PK Nail & Tag Stamped "Oakland Co. Remonumentation P.S. #25854" in W'ly Face 12" Blue Spruce N 25° W 92.06'
- PK Nail & Tag Stamped "Oakland Co. Remonumentation P.S. #25854" in W'ly Face 10" Crabapple S 14° E 25.43'
- Iron @ A-6, T2N, R9E, South 382.80'

The selected location is accepted by the Contractor and is generally accepted by professional surveyors as the best available evidence of the position of the original corner.

Signed by Randy J. Kolehouse Date Aug 3, 1998
 EARTH TECH
 Surveyor's Michigan License No. 25854

