

SURVEY & REMONUMENTATION

LIBER **17217PG477**

MAR 04 1998

LAND CORNER RECORDATION CERTIFICATE
Filing Requirement of Act 74, Mich. P.A. 1970

For corners in **SECTION**

Oakland Located In: Troy Twp. Corner Code #
(County)

1. Public Land Survey T 2N R 11E C-13
T R
T R
T R

2. Property Controlling S T R
in Section S T R

3. Miscellaneous S T R
Property in Sec. S T R

\$ 9.00 MISCELLANEOUS RECORDING
\$ 2.00 REMONUMENTATION
19 MAY 97 7:46 A.M. RECEIPT# 11A
PAID RECORDED - OAKLAND COUNTY
LYNN D. ALLEN, CLERK/REGISTER OF DEEDS

Compliance with
ACT 345, P.A. 1990

APPROVED ON: 5-9-97 TS
OAKLAND COUNTY REMONUMENTATION
PEEP GROUP COMMITTEE

Register of Deeds Stamp & File Number

4. Lot No. _____, Recorded Plat _____
5. Private Claims _____

I, Huston K. Kennedy, in a field survey on 4/1, 19 97 do hereby state that under requirements of P.A. 74, Michigan P.A. of 1970, the corner points mentioned in lines 1 and 2 above were in conformance with regulations and rules therefore as required in the current manual of survey instructions of the United States Department of the Interior, Bureau of Land Management or by a decree of a Court of Law and /or that the corner points mentioned in lines 3, 4 and 5 above were in conformance with the rules of the Michigan Board of Land Surveyors or by a Decree of a Court of Law; established, re-established, monumented, recovered, found as expressed below:

NOTE: Not more than 2 corners, all in the same town and range, may be recorded on this certificate.

	A	B	C	D	E	F	G	H	I	J	K	L	M
1													
2	6		5		4		3		2		1		
3													
4	7		8		9		10		11		12		
5													
6	16		17		16		15		14		13		
7													
8	19		20		21		22		23		24		
9													
10	30		29		28		27		26		25		
11													
12	31		32		33		34		35		36		
13													

A. Description of original monument and accessories and/or subsequent restoration:
1817-GLO Wampler, D.S.; Set Post 9" Ash N31°W 9 Links; 6" Beech S41 1/2°E 13 Links
1.) 1988-Patterson, PS #17631; LCRC L.10484, Pg.889 - Fnd P.K. Nail

B. Description of corner evidence found and/or method applied in restoring or reestablishing corner:
1997 Kennedy Surveying, Inc. - Kennedy, PS #17623 - Fnd a P.K. Nail 2 feet South of the existing centerline of 14 Mile Road extending to the East & West, which has a bituminous surface. There is a fence-tree line extending to the North. Corner common to Sections 5 & 6, T1N, R11E, Royal Oak Township (C-1) is located 100.03 feet to the East.

Witnesses from LCRC #1 were used to recover and verify the location of the found P.K. Nail.

I accepted the found P.K. Nail as the best evidence of the original corner position.

Field measurements between see back side of LCRC


*9 N File
2 00 ✓*

C. Description of monument for corner and accessories established to perpetuate locating the position of the corner:
C-13 I replaced the found P.K. Nail with a 5/8" x 24" Iron Rod w/2" diameter brass cap stamped Oakland County Remonumentation, PS #17623 in a new Monument Box
S54°E 48.17' Set PK & Remon Washer NE face Guide Pole
N70°E 131.08' Set PK & Remon Washer SE face Power Pole
S69°W 93.83' Set PK & Remon Washer NW face Light Pole
N40°W 36.35' Set PK & Remon Washer SW face Power Pole
East 100.03 Ft. corner common to Sections 5 & 6, T1N, R11E, Royal Oak Township (C-1)

The selected location is accepted by me and is generally accepted by Professional Surveyors as the best available evidence of the position of the original corner.

Signed by [Signature]
Surveyor's Michigan License No. 17623

Date 4-8-97

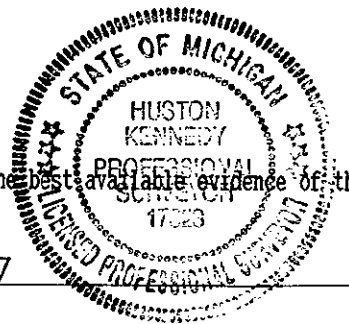

SURVEY &
REMONUMENTATION

LIBER 17217PG478

MAR 04 1998

SECTION

FIELD MEASUREMENTS BETWEEN

C-13 to B-13

GLO = 40 chains or 2640.00 Ft.
No sidwell or plat distances are available
GPS-MEA = 2634.35 Ft.

C-13 to C-1

GLO = 1.50 chains or 99.00 Ft., 100.03 Ft. (mea)

C-13 to C-12

GLO = 40 chains or 2640.00 Ft.
No sidwell or plat distances are available
GPS-MEA =

C-13 to D-13

GLO = 40 chains or 2640.00 Ft.
No sidwell or plat distances are available
GPS-MEA = 2623.43 Ft.