

SURVEY & REMONUMENTATION

JH - 9 97 1 2 4 4 6 4

MAR 0 4 1998

LIBER 172778688

SECTION

LAND CORNER RECORDATION CERTIFICATE
Filing Requirement of Act 74, Mich. P.A. 1970

Compliance with ACT 345, P.A. 1990

APPROVED ON: 5-2-97 MS
OAKLAND COUNTY REMONUMENTATION PEER GROUP COMMITTEE


For corners in

Table with columns: Oakland (County), Located in: City of Troy, Corner Code #. Rows include Public Land Survey, Property Controlling in Section, Miscellaneous Property in Sec.

\$ 7.00 MISCELLANEOUS RECORDING
\$ 2.00 REMONUMENTATION
9 JUN 97 12:19 P.M. RECEIPT# 94A
PAID RECORDED - OAKLAND COUNTY
LYNN D. ALLEN, CLERK/REGISTER OF DEEDS

Register of Deeds Stamp & File Number

- 4. Lot No.
5. Private Claims

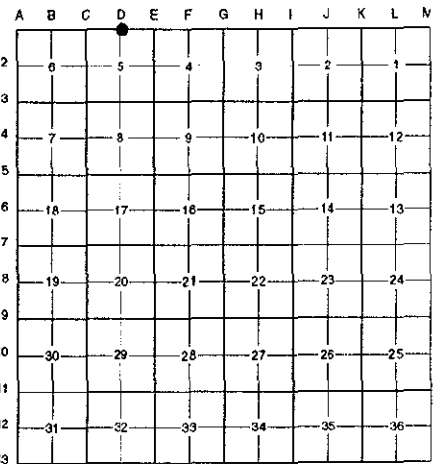

I, Randy Kolehouse, in a field survey on March 4 19 97, do hereby certify that under requirements of P.A. 74 Michigan P.A. of 1970, the corner points mentioned in lines 1 and 2 above were in conformance with regulations and rules therefore as required in the current manual of survey instructions of the United States Department of the interior, Bureau of Land Management or by a decree of a Court of Law and/or that the corner points mentioned in lines 3, 4 and 5 above were in conformance with the rules of the Michigan Board of Land Surveyors or by a Decree of a Court of Law; established, re-established, monumented, re-monumented, recovered, found as expressed below:

NOTE: Not more than 4 corners, all in the same town and range, may be recorded on this certificate.

A. Description of original monument and accessories and/or subsequent restoration:

D-1 This corner was not originally set by the G.L.O.

Table with columns: Date, Name, Description, Set Post. Includes entries for Wampler, Brown, Patterson, Marini, Avey, and O.C. Tax Maps.

Records indicate this corner is common with D-13, T3N, R11E.

B. Description of corner evidence found and/or method applied in restoring or reestablishing corner:

D-1 Found a 1/2" rebar in a monument box on the C/L of South Boulevard (bit.) running East and West and 8' West of the C/L of the drainage creek running Northerly and Southerly per L.C.R.C.'s L. 12121 P. 084, L. 12979 P. 458, and L. 16138 P. 570. Checks closely distances as shown in recorded plats, Oakland County tax records and surveys of record.

Table with columns: L.C.R.C. L. 12121 P. 084 (1991), L.C.R.C. L. 16138 P. 570 (1995), L.C.R.C. L. 12979 P. 458 (1992). Includes measurements for SW 18.91' NW Cor. of Headwall, NE 29.78' to '+', SE 28.79' to '+', and NW Face U.P. (NE Face).

Measure West 2635.65' to C-1 (G.L.O. = 2640.0') (O.C. Tax Maps = 2636.5') (Brown Survey (1967) = 2640.7')
Measure East 2646.97' to E-1 (G.L.O. = 2640.0') (Crescent Ridge Sub. No. 3 = 2646.81')

C. Description of monument for corner and accessories established to perpetuate locating the position of the corner:

D-1 Replaced 1/2" rebar with a 5/8" x 24" rebar with brass cap stamped "Oakland County Remonumentation P.S. #25854" in an existing monument box.

- "X" Cut Top West End Conc. Headwall N 10° E 20.36'
"X" Cut Top East End Conc. Headwall N 60° E 29.78'
"X" Cut Top East End Conc. Headwall S 35° E 28.79'
PK Nail & Tag Stamped "Oakland Co. Remonumentation P.S. #25854" in NE Face Util. Pole S 50° W 55.39'

The selected location is accepted by the Contractor and is generally accepted by professional surveyors as the best available evidence of the position of the original corner.

Signed by Randy J. Kolehouse
EARTH TECH

Date 5/28/97

Surveyor's Michigan License No. 25854

