

MAR 0 4 1998

LIDER 17277PG633

LAND CORNER RECORDATION CERTIFICATE
Filing Requirement of Act 74, Mich. P.A. 1970

Compliance with ACT 345, P.A. 1990

SECTION

For corners in


Table with columns: Located in: City of Troy, Corner Code #. Rows include Public Land Survey, Property Controlling in Section, Miscellaneous Property in Sec.

APPROVED ON: 4.9.97 RS
OAKLAND COUNTY REMONUMENTATION PEER GROUP COMMITTEE

\$ 9.00 MISCELLANEOUS RECORDING
\$ 2.00 REMONUMENTATION
9 JUN 97 12:15 P.M. RECEIPT# 94A
PAID RECORDED - OAKLAND COUNTY
LYNN D. ALLEN, CLERK/REGISTER OF DEEDS
Register of Deeds Stamp & File Number

- 4. Lot No. Recorded Plat
5. Private Claims

I, Randy Kolehouse, in a field survey on March 14 19 97, do hereby certify that under requirements of P.A. 74 Michigan P.A. of 1970, the corner points mentioned in lines 1 and 2 above were in conformance with regulations and rules therefore as required in the current manual of survey instructions of the United States Department of the interior, Bureau of Land Management or by a decree of a Court of Law and/or that the corner points mentioned in lines 3, 4 and 5 above were in conformance with the rules of the Michigan Board of Land Surveyors or by a Decree of a Court of Law; established, re-established, monumented, re-monumented, recovered, found as expressed below:

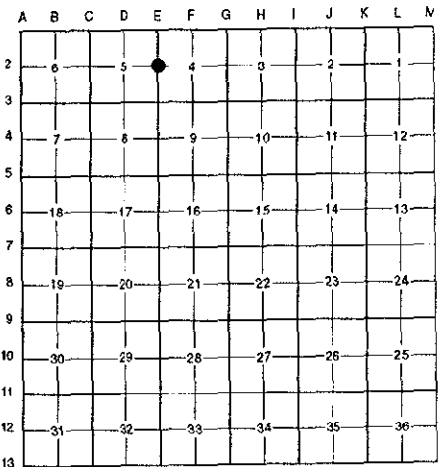

NOTE: Not more than 4 corners, all in the same town and range, may be recorded on this certificate.

A. Description of original monument and accessories and/or subsequent restoration:

Table with columns: E-2, 1817, Wampler, G.L.O. Notes, Set Post. Rows include 1926 Southern Survey N/A and 1937 Clark Survey N/A.

(Continued on Back)

B. Description of corner evidence found and/or method applied in restoring or reestablishing corner:

E-2 Found a 1/2" rebar 0.6' East of of Crooks Road (0.1' under the bituminous surface) running North and South and 165' North of the C/L of Wesley Drive (bit.) running East per L.C.R.C. L. 7034 P. 562 and an unrecorded L.C.R.C. by Wilkerson. Checks closely distances as shown in recorded plats and surveys of record.

Table comparing L.C.R.C. L. 7034 P. 562 (1977) measurements with Unrecorded L.C.R.C. (1993) measurements.


Handwritten note: 9 5' file 2"

Measure North 3463.74' to E-1 (G.L.O. = 3381.2') (Crescent Ridge Sub. No. 2 & 3 = 3463.5')
Measure South 2408.25' to E-3 (G.L.O. = 2640.0') (Southern (1926) = 2405.0') (Clark (1937) = 2405.0') (South Bridge Sub. No. 2 = 2408.25') (Crescent Ridge Sub. No. 1 = 2408.25')

C. Description of monument for corner and accessories established to perpetuate locating the position of the corner:

E-2 Replaced 1/2" rebar with a 5/8" x 24" rebar with brass cap stamped "Oakland County Remonumentation P.S. #25854." Also set a new monument box.

- PK Nail & Tag Stamped "Oakland Co. Remonumentation P.S. #25854" in NE Side Util. Pole S 29° E 81.41'
PK Nail & Tag Stamped "Oakland Co. Remonumentation P.S. #25854" in S Side Util. Pole N 89° E 45.19'
PK Nail & Tag Stamped "Oakland Co. Remonumentation P.S. #25854" in SE Side Util. Pole N 29° E 107.72'
PK Nail & Tag Stamped "Oakland Co. Remonumentation P.S. #25854" in E Side 24" Hickory S 48° W 91.90'

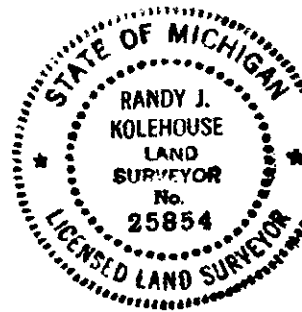

The selected location is accepted by the Contractor and is generally accepted by professional surveyors as the best available evidence of the position of the original corner.

Signed by Randy J. Kolehouse Date 5/29/97

Surveyor's Michigan License No. 25854

SURVEY &
REMONUMENTATION

LIBER 17277 PG 634

MAR 04 1998

SECTION

A. Description of original monument and accessories and/or subsequent restoration:

E-2	1977	Patterson	L.C.R.C. L. 7034 P. 562	1/2" Rerod
	1993	Wilkerson	Unrecorded L.C.R.C.	PK Nail
	N/A	Beattie	Crescent Ridge Sub. No. 2 L. 194 P. 32	N/A
	N/A	Beattie	South-Bridge Sub. No. 2 L. 205 P. 32	N/A
	N/A	N/A	O.C. Section Information	N/A
	N/A	N/A	O.C. Tax Maps	N/A

