

SURVEY & REMONUMENTATION

JN-9 97124467

MAR 04 1998

LIBER 172770691

SECTION

LAND CORNER RECORDATION CERTIFICATE
Filing Requirement of Act 74, Mich. P.A. 1970

Compliance with
 ACT 345, P.A. 1990

APPROVED ON: 4-9-97 JS
 OAKLAND COUNTY REMONUMENTATION
 PEER GROUP COMMITTEE

For corners in


<u>Oakland</u> (County)	Located in:	City of Troy	Corner Code #
1. Public Land Survey	T <u>2N</u> R <u>11E</u>		<u>E-3</u>
	T _____ R _____		_____
	T _____ R _____		_____
	T _____ R _____		_____
2. Property Controlling in Section	S _____ T _____ R _____		_____
	S _____ T _____ R _____		_____
3. Miscellaneous Property in Sec.	S _____ T _____ R _____		_____
	S _____ T _____ R _____		_____

\$ 7.00 MISCELLANEOUS RECORDING
\$ 2.00 REMONUMENTATION
 9 JUN 97 12:20 P.M. RECEIPT# 94A
 PAID RECORDED - OAKLAND COUNTY
 LYNN D. ALLEN, CLERK/REGISTER OF DEEDS

Register of Deeds Stamp & File Number

4. Lot No. _____, Recorded Plat _____
 5. Private Claims _____

I, Randy Kolehouse, in a field survey on March 27 19 97, do hereby certify that under requirements of P.A. 74 Michigan P.A. of 1970, the corner points mentioned in lines 1 and 2 above were in conformance with regulations and rules therefore as required in the current manual of survey instructions of the United States Department of the interior, Bureau of Land Management or by a decree of a Court of Law and/or that the corner points mentioned in lines 3, 4 and 5 above were in conformance with the rules of the Michigan Board of Land Surveyors or by a Decree of a Court of Law; established, re-established, monumented, re-monumented, recovered, found as expressed below:

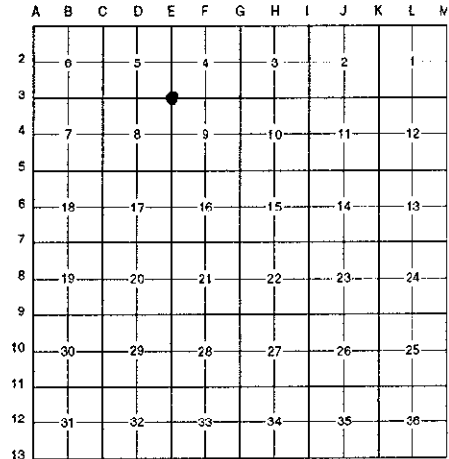

NOTE: Not more than 4 corners, all in the same town and range, may be recorded on this certificate.

A. Description of original monument and accessories and/or subsequent restoration:

E-3	1817	Wampler	G.L.O. Notes	Set Post
	1926	Southern	Survey	N/A
	1937	Clark	Survey	N/A
	1974	Stonerock	L.C.R.C. L. 6301 P. 605	1" Pipe
	1975	Pawlacyzk	L.C.R.C. L. 6576 P. 664-665	Found Monument
	1976	Stonerock	L.C.R.C. L. 6748 P. 608	1" Pipe
	1977	Patterson	L.C.R.C. L 7034 P. 564	1-1/2" Iron Pipe
	1980	Walker	Survey	N/A
	1984	Hobgood	L.C.R.C. L. 8655 P. 471	1-1/2" Iron Pipe
	1984	Giffels	Composite Survey Drawing	N/A
	1987	Kohn	L.C.R.C. L. 9870 P. 24	1-1/2" Pipe
	1987?	Menzel	Crescent Ridge Sub. No. 1 L. 172 P. 1	N/A
	1989	Beattie	South Bridge Sub. No. 2 L. 205 P. 32	N/A
	N/A	N/A	O.C. Tax Maps	N/A

B. Description of corner evidence found and/or method applied in restoring or reestablishing corner:

E-3 This corner and all witnesses have been destroyed due to recent road reconstruction. Reset corner using recorded plat information from South Bridge Sub. No. 2 and Crescent Ridge Sub. No. 1. This point checks recorded distances from plats West to D-3 and East to F-3 ± 0.02'. Checks recorded angle at E-3 meas. North to East R - 89° 44' 42" M - 89° 44' 36". Also checks ± 0.3' measurements to D-3, F-3 and E-2 from City of Troy records.

Measure North 2408.25' to E-2 (G.L.O. = 2640.0') (South Bridge Sub. No. 2 = 2408.25') (City of Troy = 2408.49')
 (Southern (1928) & Clark (1937) = 2405.0')

Measure South 2886.39' to E-4 (G.L.O. = 2640.0') (Giffels = 2886.28')

Measure West 2671.75' to D-3 (G.L.O. = 2639.3') (City of Troy = 2672.05') (Crescent Ridge Sub. No. 1 = 2671.77')

Measure East 2649.16' to F-3 (G.L.O. = 2671.68') (City of Troy = 2648.86') (South Bridge Sub. No. 2 = 2649.19')

Handwritten note: 7.5' 2.0' 2.0' ✓

C. Description of monument for corner and accessories established to perpetuate locating the position of the corner:


E-3 Set a 5/8" x 24" rebar with brass cap stamped "Oakland County Remonumentation P.S. #25854." Also set a new monument box.

PK Nail & Tag Stamped "Oakland Co. Remonumentation P.S. #25854" in N Side P. Pole N 78° E 75.50'

PK Nail & Tag Stamped "Oakland Co. Remonumentation P.S. #25854" in Top of North Guard Rail Post, E Side Crooks
 North of I-75 S 20° E 148.82'

PK Nail & Tag Stamped "Oakland Co. Remonumentation P.S. #25854" in S Side P. Pole N 70° W 103.95'
 "X" Cut SW Cor. Conc. Base to Elec. (Signal?) Box N 05° W 65.95'

The selected location is accepted by the Contractor and is generally accepted by professional surveyors as the best available evidence of the position of the original corner.

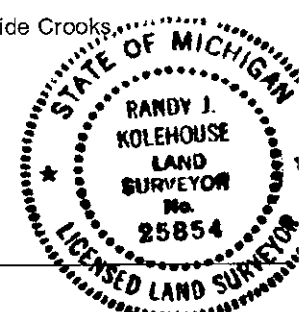

Signed by Randy J. Kolehouse Date 5/28/97
 EARTH TECH

Surveyor's Michigan License No. 25854