

MAR 04 1999

LAND CORNER RECORDATION CERTIFICATE
Filing Requirement of Act 74, Mich. P.A. 1970

Compliance with ACT 345, P.A. 1990

SECTION

For corners in


Table with columns: Oakland (County), Located in: City of Troy, Corner Code #. Rows include Public Land Survey, Property Controlling in Section, Miscellaneous Property in Sec.

APPROVED ON: 4-9-97 RS
OAKLAND COUNTY REMONUMENTATION PEER GROUP COMMITTEE

\$ 9.00 MISCELLANEOUS RECORDING
\$ 2.00 REMONUMENTATION
9 JUN 97 12:15 P.M. RECEIPT# 99A
PAID RECORDED - OAKLAND COUNTY
LYNN D. ALLEN, CLERK/REGISTER OF DEEDS
Register of Deeds Stamp & File Number

- 4. Lot No. , Recorded Plat
5. Private Claims

I, Randy Kolehhouse, in a field survey on March 14 19 97, do hereby certify that under requirements of P.A. 74 Michigan P.A. of 1970, the corner points mentioned in lines 1 and 2 above were in conformance with regulations and rules therefore as required in the current manual of survey instructions of the United States Department of the interior, Bureau of Land Management or by a decree of a Court of Law and/or that the corner points mentioned in lines 3, 4 and 5 above were in conformance with the rules of the Michigan Board of Land Surveyors or by a Decree of a Court of Law; established, re-established, monumented, re-monumented, recovered, found as expressed below:

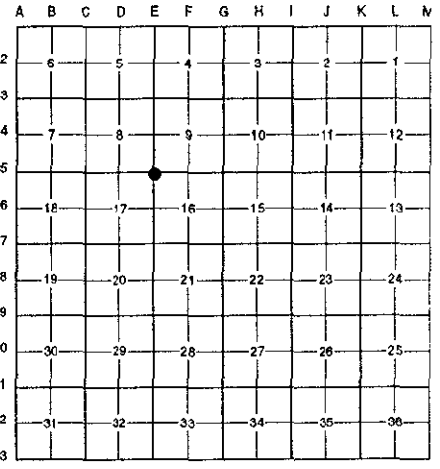

NOTE: Not more than 4 corners, all in the same town and range, may be recorded on this certificate.

A. Description of original monument and accessories and/or subsequent restoration:

Table with columns: E-5, 1817, Wampler, G.L.O. Notes, Set Post. Rows include 1963 N/A, 1974 Stonerock, 1978 Patterson.

B. Description of corner evidence found and/or method applied in restoring or reestablishing corner:

E-5 Found a 1/2" rebar in a monument box 21.6' East of the C/L of Crooks Road (conc.) running North and South and 15.5' South of the C/L of West Long Lake Road (conc.) running East and West per L.C.R.C. L. 10228 P. 454 and an unrecorded L.C.R.C. by Wilkerson. Checks closely distances as shown in recorded plats, Oakland County tax records and surveys of record.

Table comparing L.C.R.C. L. 10228 P. 454 (1987) measurements with Unrecorded L.C.R.C. (1993) measurements.

Measure North 2536.21' to E-4 (G.L.O. = 2640.0') (Walker (1980) = 2536.84') (Giffels = 2536.17')
Measure South 2762.82' to E-6 (G.L.O. = 2640.0') (Merihill Acres Sub. No. 3 = 2762.4')
Measure East 2613.8' to F-5 (G.L.O. = 2638.7') (O.C. Tax Maps = 2614.5')
Measure West 2643.72' to D-5 (G.L.O. = 2639.0') (Giffels = 2643.82')

4th FILE
1st

C. Description of monument for corner and accessories established to perpetuate locating the position of the corner:

E-5 Replaced the 1/2" rebar with a 5/8" x 24" rebar with brass cap stamped "Oakland County Remonumentation P.S. #25854" in an existing monument box.


- PK Nail & Tag Stamped "Oakland Co. Remonumentation P.S. #25854" in "X" Cut in Top of NE Bolt Steel Pole Base S 60° W 136.83'
PK Nail & Tag Stamped "Oakland Co. Remonumentation P.S. #25854" in "X" Cut in Top of SE Bolt Steel Pole Base N 50° W 26.20'
PK Nail & Tag Stamped "Oakland Co. Remonumentation P.S. #25854" in "X" Cut in Top of E Bolt Steel Pole Base S 30° E 102.27'
PK Nail & Tag Stamped "Oakland Co. Remonumentation P.S. #25854" in "X" Cut in Top of SW Bolt Steel Pole Base N 31° E 135.85'
PK Nail & Tag Stamped "Oakland Co. Remonumentation P.S. #25854" in "X" Cut in Top of SE Bolt Steel Pole Base N 31° W 162.77'

The selected location is accepted by the Contractor and is generally accepted by professional surveyors as the best available evidence of the position of the original corner.

Signed by Randy J. Kolehhouse

Date 5/29/97

Surveyor's Michigan License No. 25854

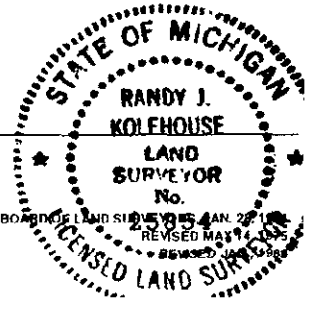

MAR 04 1998

SECTION

A. Description of original monument and accessories and/or subsequent restoration:

E-5	1980	Walker	Survey	N/A
	1982	Graham	Survey	N/A
	1984	Giffels	Composite Survey Drawing	N/A
	1987	Kohn	L.C.R.C. L. 9870 P. 24	5/8" Iron in Asphalt
	1987	O'Rourke	L.C.R.C. L. 10228 P. 454	1/2" Iron Bar in Mon. Box
	1993	Wilkerson	Unrecorded L.C.R.C.	1/2" Iron
	1994	Marini	L.C.R.C. L. 14680 P. 13	1/2" Iron in Mon. Box
	N/A	N/A	O.C. Section Information	N/A
	N/A	N/A	O.C. Tax Maps	N/A

