

SURVEY & REMONUMENTATION

MAR 04 1998

LIBER 17277 PC 693

JN-997124469

Compliance with ACT 345, P.A. 1990

LAND CORNER RECORDATION CERTIFICATE
Filing Requirement of Act 74, Mich. P.A. 1970

APPROVED ON: 4-9-97 JS
OAKLAND COUNTY REMONUMENTATION PEER GROUP COMMITTEE

SECTION

For corners in


Oakland (County)	Located in:	City of Troy	Corner Code #
1. Public Land Survey	T 2N	R 11E	E-6
	T	R	
	T	R	
	T	R	
2. Property Controlling in Section	S	T	R
	S	T	R
3. Miscellaneous Property in Sec.	S	T	R
	S	T	R

\$ 7.00 MISCELLANEOUS RECORDING
\$ 2.00 REMONUMENTATION
9 JUN 97 12:20 P.M. RECEIPT# 94A
PAID RECORDED - OAKLAND COUNTY
LYNN D. ALLEN, CLERK/REGISTER OF DEEDS

Register of Deeds Stamp & File Number

- 4. Lot No. _____, Recorded Plat _____
- 5. Private Claims _____

I, Randy Kolehouse, in a field survey on March 17 19 97, do hereby certify that under requirements of P.A. 74 Michigan P.A. of 1970, the corner points mentioned in lines 1 and 2 above were in conformance with regulations and rules therefore as required in the current manual of survey instructions of the United States Department of the interior, Bureau of Land Management or by a decree of a Court of Law and/or that the corner points mentioned in lines 3, 4 and 5 above were in conformance with the rules of the Michigan Board of Land Surveyors or by a Decree of a Court of Law; established, re-established, monumented, re-monumented, recovered, found as expressed below:

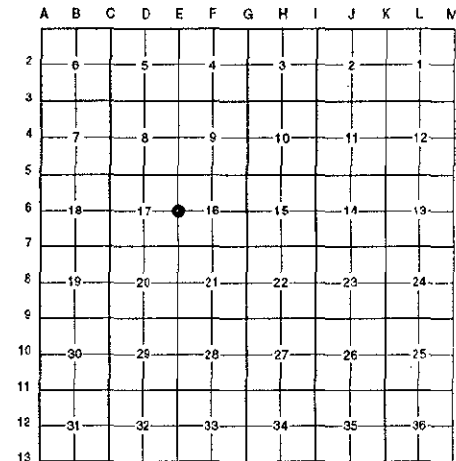

NOTE: Not more than 4 corners, all in the same town and range, may be recorded on this certificate.

A. Description of original monument and accessories and/or subsequent restoration:

E-6	1817	Wampler	G.L.O. Notes	Set Post
	1946	Nampa	Survey	N/A
	1974	Stonerock	L.C.R.C. L. 6301 P. 607	1/2" Iron
	1978	Patterson	L.C.R.C. L. 7326 P. 394	1/2" Rerod
	1986	Beattie	Merihill Acres Sub. No. 3 L. 189 P. 7	N/A
	1987	Kohn	L.C.R.C. L. 9870 P. 25	PK Nail
	1987	O'Rourke	L.C.R.C. L. 10228 P. 455	PK Nail in Concrete
	1993	Wilkerson	Unrecorded L.C.R.C.	Mon. Box
	N/A	N/A	O.C. Section Information	N/A
	N/A	N/A	O.C. Tax Maps	N/A

B. Description of corner evidence found and/or method applied in restoring or reestablishing corner:

E-6 Found a 1/2" rebar in a monument box in the C/L of Crooks Road (conc.) running North and South on line of a tree row running West per L.C.R.C.'s L. 7326 P. 394, L. 10228 P. 455 and an unrecorded L.C.R.C. by Wilkerson. Checks closely distances as shown in recorded plats and Oakland County tax records.

L.C.R.C. L. 7326 P. 394 (1978) NW'ly 140.00' Center of Hyd.(m. 139.5')	L.C.R.C. L. 10228 P. 455 (1987) N 85° E 87.25' PK Nail S Face Honey Locust S 45° W 70.60' PK Nail S Face of U.P. West 137.72' Concrete Monument N 20° W 139.50' "X" in Top Nut of Hyd.	Unrecorded L.C.R.C. (1993) S 45° W 70.60' PK Nail in S Face of U.P. West 137.72' Concrete Monument N 20° W 139.50' "X" on Top Nut of Hyd.
---	--	--

Measure North 2762.82' to E-5 (G.L.O. = 2640.0') (Merihill Acres Sub. No. 3 = 2762.48')
Measure South 2449.3' to E-7 (G.L.O. = 2640.0') (O.C. Tax Maps = 2447.1')

700 FILE
2nd FILE

C. Description of monument for corner and accessories established to perpetuate locating the position of the corner:

E-6 Placed a brass cap stamped "Oakland County Remonumentation P.S. #25854" on an existing 1/2" rebar in an existing monument box.

"X" on Top Nut of Hyd. N 09° W 139.50'
Conc. Mon. West 137.72'
PK Nail & Tag Stamped "Oakland Co. Remonumentation P.S. #25854" in S Side 16" Locust E 86.46'
PK Nail & Tag Stamped "Oakland Co. Remonumentation P.S. #25854" in SE Side Util. Pole S 53° W 70.60'

The selected location is accepted by the Contractor and is generally accepted by professional surveyors as the best available evidence of the position of the original corner.

Signed by Randy J. Kolehouse Date 5/29/97
Surveyor's Michigan License No. 25854

