

SURVEY & REMONUMENTATION

LIBER 172777694

MAR 04 1998

Compliance with ACT 345, P.A. 1990

LAND CORNER RECORDATION CERTIFICATE

APPROVED ON: 4-9-97 JS OAKLAND COUNTY REMONUMENTATION PEER GROUP COMMITTEE


For corners in SECTION

Table with columns: Oakland (County), Located in: City of Troy, Corner Code #. Rows include Public Land Survey, Property Controlling in Section, Miscellaneous Property in Sec., Lot No., and Private Claims.

\$ 7.00 MISCELLANEOUS RECORDING \$ 2.00 REMONUMENTATION 9 JUN 97 12:20 P.M. RECEIPT# 94A PAID RECORDED - OAKLAND COUNTY LYNN D. ALLEN, CLERK/REGISTER OF DEEDS

Register of Deeds Stamp & File Number

I, Randy Kolehouse, in a field survey on February 5, 1997, do hereby certify that under requirements of P.A. 74 Michigan P.A. of 1970, the corner points mentioned in lines 1 and 2 above were in conformance with regulations and rules therefore as required in the current manual of survey instructions of the United States Department of the interior, Bureau of Land Management or by a decree of a Court of Law and/or that the corner points mentioned in lines 3, 4 and 5 above were in conformance with the rules of the Michigan Board of Land Surveyors or by a Decree of a Court of Law; established, re-established, monumented, re-monumented, recovered, found as expressed below:

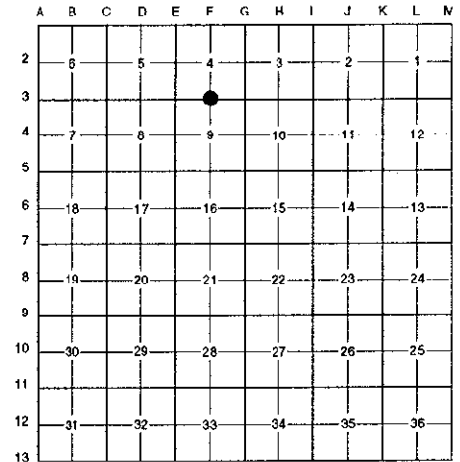

NOTE: Not more than 4 corners, all in the same town and range, may be recorded on this certificate.

A. Description of original monument and accessories and/or subsequent restoration:

Table with columns: F-3, 1817, Wampler, G.L.O. Notes, Set Post. Lists various survey points and their corresponding monuments like Wampler, MacNutt, Pawlaczyk, Patterson, Wilkerson, Beattie, etc.

B. Description of corner evidence found and/or method applied in restoring or reestablishing corner:

F-3 Found a 1" bar in a monument box 1' North of the C/L of Square Lake Road (bit.) running East and West on line of a tree row running North and a tree row and fence line running South per L.C.R.C.'s L. 6576 P. 664, L. 7034 P. 564, and an unrecorded L.C.R.C. by Wilkerson. Checks closely distances as shown in recorded plats, Oakland County tax records and surveys of record.

L.C.R.C. L. 6576 P. 664 (1975) NW'ly 79.75' N w/Tag #3460 in 36" Elm (m. 80.00') Unrecorded Survey (1993) S 08° W 34.05' PK Nail E Face U.P. N 22° W 79.40' Nail/Tag SW Face 36" Elm

L.C.R.C. L. 7034 P. 564 (1977) S'ly 34.04' PK Nail in U.P.

Measure West 2649.16' to E-3 (G.L.O. = 2671.7') (South-Bridge Sub. #2 = 2649.17') (O.C. Section Info. = 2649.3') Measure East 2592.05' to G-3 (G.L.O. = 2671.7') (MacNutt = 2592.4') (O.C. Section Info. = 2591.5')

C. Description of monument for corner and accessories established to perpetuate locating the position of the corner:

F-3 Replaced 1" bar with a 5/8" x 24" rebar with brass cap stamped "Oakland County Remonumentation P.S. #25854" in an existing monument box.

- PK Nail & Tag Stamped "Oakland Co. Remonumentation P.S. #25854" in SW Side 38" Elm N 29° W 80.00'
PK Nail & Tag Stamped "Oakland Co. Remonumentation P.S. #25854" in N Side P. Pole N 64° E 55.38'
PK Nail & Tag Stamped "Oakland Co. Remonumentation P.S. #25854" in NW Side 22" Elm S 70° W 91.35'
PK Nail & Tag Stamped "Oakland Co. Remonumentation P.S. #25854" in E Side Util. Pole S 08° W 34.05'
PK Nail & Tag Stamped "Oakland Co. Remonumentation P.S. #25854" in SW Side 36" Elm N 22° W 79.40'

The selected location is accepted by the Contractor and is generally accepted by professional surveyors as the best available evidence of the position of the original corner.

Signed by Randy J. Kolehouse EARTH TECH

Date 5/28/97

Surveyor's Michigan License No. 25854

