

SURVEY & REMONUMENTATION

JH - 97124

MAR 04 1998

LIBER 17277 PG 639

SECTION

LAND CORNER RECORDATION CERTIFICATE
Filing Requirement of Act 74, Mich. P.A. 1970

Compliance with
ACT 345, P.A. 1990

For corners in

| _____ Oakland _____ (County) | Located in: | City of Troy | Corner Code # |
|---------------------------------------|-------------|-----------------|---------------|
| 1. Public Land Survey | T <u>2N</u> | R <u>11E</u> | <u>F-5</u> |
| | T _____ | R _____ | _____ |
| | T _____ | R _____ | _____ |
| | T _____ | R _____ | _____ |
| 2. Property Controlling in Section | S _____ | T _____ | R _____ |
| | S _____ | T _____ | R _____ |
| 3. Miscellaneous Property in Sec. | S _____ | T _____ | R _____ |
| | S _____ | T _____ | R _____ |


APPROVED ON: 4-9-97 JS
OAKLAND COUNTY REMONUMENTATION
PEER GROUP COMMITTEE

\$ 9.00 MISCELLANEOUS RECORDING
\$ 2.00 REMONUMENTATION
9 JUN 97 12:15 P.M. RECEIPT# 94A
PAID RECORDED - OAKLAND COUNTY
LYNN D. ALLEN, CLERK/REGISTER OF DEEDS
Register of Deeds Stamp & File Number

JH-97124437

4. Lot No. _____, Recorded Plat _____
5. Private Claims _____

I, Randy Kolehouse, in a field survey on February 6 19 97, do hereby certify that under requirements of P.A. 74 Michigan P.A. of 1970, the corner points mentioned in lines 1 and 2 above were in conformance with regulations and rules therefore as required in the current manual of survey instructions of the United States Department of the Interior, Bureau of Land Management or by a decree of a Court of Law and/or that the corner points mentioned in lines 3, 4 and 5 above were in conformance with the rules of the Michigan Board of Land Surveyors or by a Decree of a Court of Law; established, re-established, monumented, re-monumented, recovered, found as expressed below:

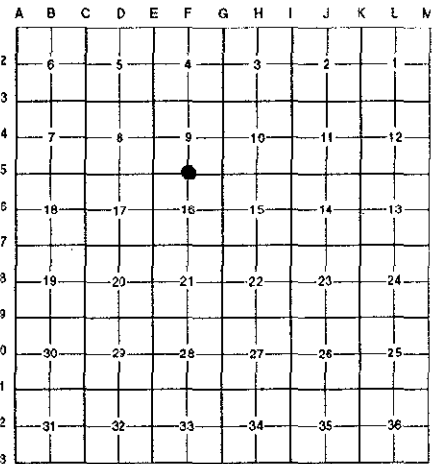

NOTE: Not more than 4 corners, all in the same town and range, may be recorded on this certificate.

A. Description of original monument and accessories and/or subsequent restoration:

| F-5 | 1817 | Wampler | G.L.O. Notes | Set Post |
|-----|------|-------------|------------------------------|--------------|
| | 1964 | N/A | O.C.R.C. Section Corner Ties | Nail and Cap |
| | 1972 | P.E.A. Inc. | O.C.R.C. Section Corner Ties | N/A |
| | 1974 | Stonerock | L.C.R.C. L. 6301 P. 621 | Fnd. Nail |
| | 1975 | Pawlaczyk | L.C.R.C. L. 6576 P. 664-665 | Fnd. Nail |

(Continued on Back)

B. Description of corner evidence found and/or method applied in restoring or reestablishing corner:

F-5 Found a 1/2" rebar in a monument box on the C/L of West Long Lake Road (conc.) running East and West on the East right-of-way line of I-75, 50' ± East of the I-75 overpass, on line of a fence running North and South per L.C.R.C.'s L. 6301 P. 621, L. 6576 P. 664, L. 9870 P. 25, L. 10228 P. 457, L. 11062 P. 220 and an unrecorded L.C.R.C. by Wilkerson. Checks closely distances as shown in the MDOT Right-of-Way Plans, Oakland County tax records and surveys of record.

- | | |
|--|---|
| L.C.R.C. L. 6576 P. 664 (1975) Due North 49.41' P.P. SW 85.8' Bridge Pier | L.C.R.C. L. 11062 P. 220 (1989) N 05° E 49.05' GW Tag W Face U.P. S 25° W 52.63' PK w/RJD Tag E Face Dbl. 4" Tree S 74° W 83.55' NE Corner Concrete Support Column I-75 Overpass (m. 84.58') N 65° W 84.47' SE Corner Concrete Support Column I-75 Overpass |
| L.C.R.C. L. 10228 P. 457 (1987) N 02° W 49.75' PK Nail in W Face U.P. N 45° E 115.60' PK in W Face 20" Maple | |
| Measure East 2652.96' to G-5 (G.L.O. = 2638.7') (O.C. Tax Maps = 2653.0') (O.C. Section Info. = 2652.67') | |
| Measure West 2613.8' to E-5 (G.L.O. = 2638.7') (MDOT & Walker Survey = 2614.9' ±) | |


900 file
200

C. Description of monument for corner and accessories established to perpetuate locating the position of the corner:

F-5 Replaced 1/2" rebar with a 5/8" x 24" rebar with brass cap stamped "Oakland County Remonumentation P.S. #25854" in an existing monument box.

- PK Nail & Tag Stamped "Oakland Co. Remonumentation P.S. #25854" in W Side P. Pole N 05° E 49.05'
- PK Nail & Tag Stamped "Oakland Co. Remonumentation P.S. #25854" in E Side of Twin 8" Locust S 25° W 52.63'
- PK Nail & Tag Stamped "Oakland Co. Remonumentation P.S. #25854" in W Side 26" Maple N 45° E 115.60'
- NE Corner Concrete Support Column for I-75 Overpass S 75° W 84.58'
- SE Corner Concrete Support Column for I-75 Overpass N 65° W 84.47'

The selected location is accepted by the Contractor and is generally accepted by professional surveyors as the best available evidence of the position of the original corner.

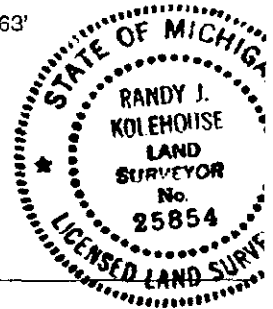

Signed by Randy J. Kolehouse
EARTH TECH

Date 5/28/97

Surveyor's Michigan License No. 25854

SURVEY &
REMONUMENTATION

LIBER 17277 PG 640

MAR 04 1998

SECTION

A. Description of original monument and accessories and/or subsequent restoration:

| | | | | |
|-----|------|-----------|--------------------------|-----------|
| F-5 | 1980 | Walker | Survey | Iron |
| | 1980 | Walker | Survey | Iron |
| | 1980 | Walker | Survey | Iron |
| | 1987 | Kohn | L.C.R.C. L. 9870 P. 25 | Fnd. PK |
| | 1987 | O'Rourke | L.C.R.C. L. 10228 P. 457 | Fnd. PK |
| | 1988 | Donnelly | Rezoning Sketch | N/A |
| | 1989 | Donnelly | L.C.R.C. L. 11062 P. 220 | 1/2' Iron |
| | 1993 | Wilkerson | Unrecorded L.C.R.C. | Iron |
| | N/A | N/A | O.C. Section Information | N/A |
| | N/A | N/A | O.C. Tax Maps | N/A |