

SURVEY & REMONUMENTATION

MAR 04 1998

LIBER 17277 PG 645

LAND CORNER RECORDATION CERTIFICATE
Filing Requirement of Act 74, Mich. P.A. 1970

SECTION

For corners in


Table with columns: Located in: (Oakland County), City of Troy, Corner Code # (G-3), and survey details for Public Land Survey, Property Controlling, and Miscellaneous Property in Sec.

Compliance with ACT 345, P.A. 1990
APPROVED ON: 3-26-97 FS
OAKLAND COUNTY REMONUMENTATION PEER GROUP COMMITTEE

\$ 9.00 MISCELLANEOUS RECORDING
\$ 2.00 REMONUMENTATION
9 JUN 97 12:16 P.M. RECEIPT# 94A
REGISTER OF DEEDS & FILE NUMBER
LYNN D. ALLEN, CLERK/REGISTER OF DEEDS

- 4. Lot No.
5. Private Claims

I, Randy Kolehouse, in a field survey on March 7 19 97, do hereby certify that under requirements of P.A. 74 Michigan P.A. of 1970, the corner points mentioned in lines 1 and 2 above were in conformance with regulations and rules therefore as required in the current manual of survey instructions of the United States Department of the interior, Bureau of Land Management or by a decree of a Court of Law and/or that the corner points mentioned in lines 3, 4 and 5 above were in conformance with the rules of the Michigan Board of Land Surveyors or by a Decree of a Court of Law; established, re-established, monumented, re-monumented, recovered, found as expressed below:

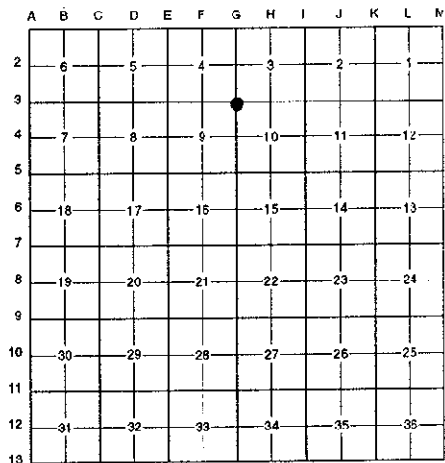

NOTE: Not more than 4 corners, all in the same town and range, may be recorded on this certificate.

A. Description of original monument and accessories and/or subsequent restoration:

Table with columns: G-3, 1817, Wampler, G.L.O. Noted, Set Post, 1921, Southern, Survey, N/A, 1937, Lister, Survey, N/A

(Continued on Back)

B. Description of corner evidence found and/or method applied in restoring or reestablishing corner:

G-3 Found a 1/2" rebar in a monument box at the G/L intersection of Livernois Road (bit.) running North and South and Square Lake Road (bit.) running East and West per L.C.R.C.'s L. 6301 P. 621, L. 8108 P. 520 and an unrecorded L.C.R.C. by Wilkerson. Checks closely distances as shown in recorded plats, Oakland County tax records and surveys of record.

L.C.R.C. L. 6301 P. 621 (1974) S 45° E 50.18' Nail in P.P.
Unrecorded L.C.R.C. (1993) S 53° E 50.16' Nail in NE Face P.P. (m. 50.25') S 52° W 54.60' PK in D.E. Pole (m. 54.62') N 64° W 62.85' Nail/Tag in P.P. (m. 62.88')

L.C.R.C. L. 8108 P. 520 (1981) N 45° W 62.05' Nail & Tag in D.E. Pole S 45° W 54.65' PK Nail in D.E Pole
Measure North 2419.59' to G-2 (G.L.O. = 2640.0') (Telford Ridge = 2419.33') (Unknown Survey = 2418.4')
Measure South 2892.68' to G-4 (G.L.O. = 2640.0') (O.C. Section Info. = 2894 ±)
Measure West 2592.1' to F-3 (G.L.O. = 2640.0') (MacNutt Survey (1950) = 2593.1')
Measure East 2658.10' to H-3 (G.L.O. = 2677.0') (MCS Survey (1980) = 2658.27'


FILED

C. Description of monument for corner and accessories established to perpetuate locating the position of the corner:

G-3 Placed a brass cap stamped "Oakland County Remonumentation P.S. #25854" on an existing 1/2" rebar in an existing monument box.

PK Nail & Tag Stamped "Oakland Co. Remonumentation P.S. #25854" in NW Side Util. Pole N 53° E 69.15'
PK Nail & Tag Stamped "Oakland Co. Remonumentation P.S. #25854" in SW Side Util. Pole S 50° E 50.25'
PK Nail & Tag Stamped "Oakland Co. Remonumentation P.S. #25854" in NW Side Util. Pole S 52° W 54.62'
PK Nail & Tag Stamped "Oakland Co. Remonumentation P.S. #25854" in S Side Util. Pole N 65° W 62.88'

The selected location is accepted by the Contractor and is generally accepted by professional surveyors as the best available evidence of the position of the original corner.

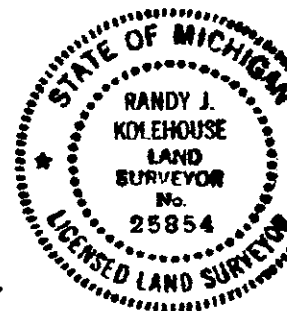

Signed by Randy J. Kolehouse Date 5/28/97

Surveyor's Michigan License No. 25854

SURVEY &  
REMONUMENTATION

MAR 04 1998

LIBER 17277 PG 646

SECTION

A. Description of original monument and accessories and/or subsequent restoration:

G-3	N/A	N/A	Survey	N/A
	N/A	N/A	Survey	N/A
	1937	Lister	Survey	NW Cor.
	1949	MacNutt	Survey	N/A
	1950	MacNutt	Survey	N/A
	1974	Stonerock	L.C.R.C. L. 6301 P. 621	No Iron Mon. Only
	1978	Smith	Survey L. 7244 P. 151	N/A
	1980	MSC Eng.	Survey	N/A
	1981	Buckerfield	L.C.R.C. L. 8108 P. 520	3/4" Pipe
	1989	Beattie	Telford Ridge L. 206 P. 24	N/A
	1993	Wilkerson	Unrecorded L.C.R.C.	Mon. Box Empty
	N/A	N/A	O.C. Section Information	N/A
	N/A	N/A	O.C. Tax Maps	N/A

