

**SURVEY & REMONUMENTATION**

JN-9 97124471

MAR 04 1998

LIBER 17277 PG 695

**LAND CORNER RECORDATION CERTIFICATE**  
 Filing Requirement of Act 74, Mich. P.A. 1970

Compliance with ACT 345, P.A. 1990

**SECTION**

For corners in

Oakland (County)	Located in:	City of Troy	Corner Code #
1. Public Land Survey	T <u>2N</u>	R <u>11E</u>	<u>G-4</u>
	T _____	R _____	_____
	T _____	R _____	_____
	T _____	R _____	_____
2. Property Controlling in Section	S _____	T _____	R _____
	S _____	T _____	R _____
3. Miscellaneous Property in Sec.	S _____	T _____	R _____
	S _____	T _____	R _____


APPROVED ON: 4-9-97 JS  
 OAKLAND COUNTY REMONUMENTATION PEER GROUP COMMITTEE

**\$ 7.00 MISCELLANEOUS RECORDING**  
**\$ 2.00 REMONUMENTATION**  
 9 JUN 97 12:21 P.M. RECEIPT# 94A  
 PAID RECORDED - OAKLAND COUNTY  
 LYNN D. ALLEN, CLERK/REGISTER OF DEEDS

Register of Deeds Stamp & File Number

4. Lot No. \_\_\_\_\_, Recorded Plat \_\_\_\_\_  
 5. Private Claims \_\_\_\_\_

I, Randy Kolehouse, in a field survey on March 10 19 97, do hereby certify that under requirements of P.A. 74 Michigan P.A. of 1970, the corner points mentioned in lines 1 and 2 above were in conformance with regulations and rules therefore as required in the current manual of survey instructions of the United States Department of the interior, Bureau of Land Management or by a decree of a Court of Law and/or that the corner points mentioned in lines 3, 4 and 5 above were in conformance with the rules of the Michigan Board of Land Surveyors or by a Decree of a Court of Law; established, re-established, monumented, re-monumented, recovered, found as expressed below:

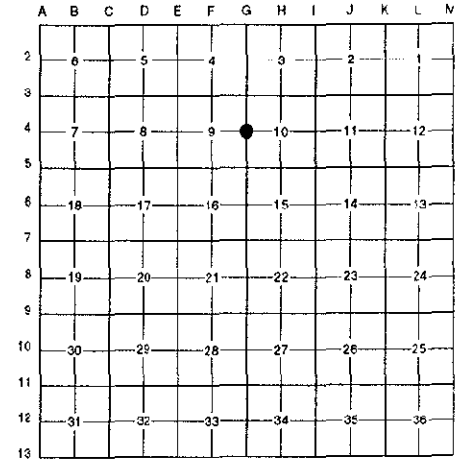

**NOTE: Not more than 4 corners, all in the same town and range, may be recorded on this certificate.**

**A. Description of original monument and accessories and/or subsequent restoration:**

G-4	1817	Wampler	G.L.O.	Set Post
	N/A	N/A	Sylvan Glen Sub. No. 2 L. 132 P. 13	N/A
	N/A	N/A	Supervisor's Plat No. 25	N/A
	N/A	N/A	O.C. Tax Maps	N/A

**B. Description of corner evidence found and/or method applied in restoring or reestablishing corner:**

G-4 Found a PK nail 6' East of the C/L of Livernois (bit.) running North and South and 14' South of the C/L of McKinley Road (bit.) running West and 120' ± North of the C/L of Winchester Drive running East. This point checks the recorded distance South to G-5 as shown in Sylvan Glen Sub. No. 2 ± 0.2' and also checks 60' West of irons found along the East right-of-way line of Livernois Road. Checks closely distances as shown in the Oakland County tax records.

*7-0 File B* ✓


Measure North 2892.68' to G-3 (G.L.O. = 2640.0') (Tax Maps = 2894.2')  
 Measure South 2527.66' to G-5 (G.L.O. = 2640.0') (Tax Maps & Two Acres Farm Sub. = 2529.2') (Sylvan Glen Sub. No. 2 = 2527.45')

**C. Description of monument for corner and accessories established to perpetuate locating the position of the corner:**

G-4 Replaced the PK nail with a 5/8" x 24" rebar with brass cap stamped "Oakland County Remonumentation P.S. #25854." Also set a new monument box.

- PK Nail & Tag Stamped "Oakland Co. Remonumentation P.S. #25854" in NW Side Util. Pole S 32° W 141.98'
- PK Nail & Tag Stamped "Oakland Co. Remonumentation P.S. #25854" in NE Side Util. Pole N 40° W 79.25'
- PK Nail & Tag Stamped "Oakland Co. Remonumentation P.S. #25854" in SE Side 14" Elm N 50° E 59.36'
- C/L Top Nut Hyd. S 26° E 86.01'
- 1/2" Rebar @ SE Cor. Livernois & Winchester S 15° E 161.78'
- 1/2" Rebar N 90° E 60.00'

The selected location is accepted by the Contractor and is generally accepted by professional surveyors as the best available evidence of the position of the original corner.

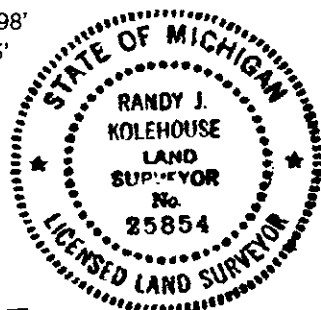

Signed by Randy J. Kolehouse Date 5/22/97

Surveyor's Michigan License No. 25854