

SURVEY & REMONUMENTATION

LIBER 172770647

MAR 04 1998


LAND CORNER RECORDATION CERTIFICATE Filing Requirement of Act 74, Mich. P.A. 1970

Compliance with ACT 345, P.A. 1990

For corners in SECTION Oakland (County) Located in: City of Troy Corner Code # 1. Public Land Survey T 2N R 11E G-5 2. Property Controlling in Section S T R 3. Miscellaneous Property in Sec. S T R 4. Lot No. , Recorded Plat 5. Private Claims

APPROVED ON: 3-26-97 OAKLAND COUNTY REMONUMENTATION PEER GROUP COMMITTEE

\$ 9.00 MISCELLANEOUS RECORDING \$ 2.00 REMONUMENTATION 9 JUN 97 12:16 P.M. RECEIPT# 94A PAID REGISTERED - OAKLAND COUNTY

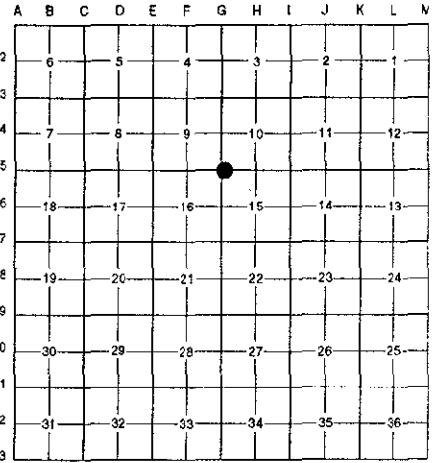

I, Randy Kolehouse, in a field survey on March 7, 1997, do hereby certify that under requirements of P.A. 74 Michigan P.A. of 1970, the corner points mentioned in lines 1 and 2 above were in conformance with regulations and rules therefore as required in the current manual of survey instructions of the United States Department of the interior, Bureau of Land Management or by a decree of a Court of Law and/or that the corner points mentioned in lines 3, 4 and 5 above were in conformance with the rules of the Michigan Board of Land Surveyors or by a Decree of a Court of Law; established, re-established, monumented, re-monumented, recovered, found as expressed below:

NOTE: Not more than 4 corners, all in the same town and range, may be recorded on this certificate.

A. Description of original monument and accessories and/or subsequent restoration: G-5 1817 Wampler G.L.O. Notes Set Post 1946 Johnson Survey N/A

B. Description of corner evidence found and/or method applied in restoring or reestablishing corner: G-5 Found a 1" iron pipe in a monument box at the C/L intersection of Livernois Road (conc.) running North and South and Long Lake Road (conc.) running East and West as set by Richard Boldt in 1994 in place of a 3/4" iron pipe and a split 8" sandstone he found during road reconstruction that checks survey records back to 1921 (see L.C.R.C. L.14757 P. 709). Also checks witnesses per L.C.R.C.'s L. 15499 P. 267 and L. 16303 P. 498. Checks closely distances as shown in the Oakland County tax records.

- L.C.R.C. L. 14757 P. 709 (1993) N 45° E 92.98' City of Troy Tag #6248 in SW Side P.P. S 45° E 95.61' "+" in Top of N Bolt of Conc. Guide Pole Base N 45° W 91.86' City of Troy Tag #6254 in SW Side Wood P.P. L.C.R.C. L. 16303 P. 498 (1996) N 43° E 92.33' Nail w/Tag W Face U.P. S 85° E 51.59' Cut "X" in SE Bolt of Traffic Signal Pole West 57.64' Nail w/Tag E Face U.P. N 41° W 91.64' PK Nail w/Tag SW Face U.P. L.C.R.C. L. 15499 P. 267 (1995) N 45° E 93.00' Troy Tag #6248 in U.P. East 51.65' "X" on SW Bolt of Guy Pole N 45° W 91.81' Troy Tag #6248 in U.P. S 25° W 159.82' PK SE/Face P.P.


Measure North 2572.67' to G-4 (G.L.O. = 2640.0') (Tax Maps = 2586.0') Measure South 2741.69' to G-6 (G.L.O. = 2640.0') (Tax Maps = 2740.3') Measure West 2653.0' to F-5 (G.L.O. = 2638.7') Measure East 2732.39' to H-5 (G.L.O. = 2682.9') (Beaver Hills Sub. & Two Acre Farms Sub. = 2653.85')

C. Description of monument for corner and accessories established to perpetuate locating the position of the corner: G-5 Replaced 1" iron pipe with a 5/8" x 24" rebar with brass cap stamped "Oakland County Remonumentation P.S. #25854" in an existing monument box.

- "X" Cut in Top of SW Bolt Light Pole Base S 85° E 51.59' PK Nail & Tag Stamped "Oakland Co. Remonumentation P.S. #25854" in SE Side Util. Pole N 45° E 92.92' PK Nail & Tag Stamped "Oakland Co. Remonumentation P.S. #25854" in SW Side Util. Pole N 41° W 91.64' PK Nail & Tag Stamped "Oakland Co. Remonumentation P.S. #25854" in N Side Util. Pole N 90° W 58.10' PK Nail & Tag Stamped "Oakland Co. Remonumentation P.S. #25854" in SE Side Util. Pole S 25° W 159.82'

The selected location is accepted by the Contractor and is generally accepted by professional surveyors as the best available evidence of the position of the original corner.

Signed by Randy J. Kolehouse Date 5/28/97 Surveyor's Michigan License No. 25854

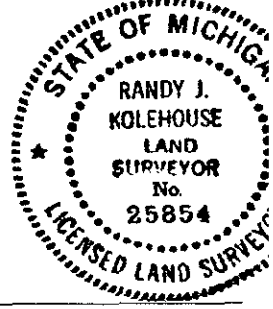

SURVEY &
REMONUMENTATION

MAR 04 1998

LIBER 17277PG648

SECTION

A. Description of original monument and accessories and/or subsequent restoration:

G-5	1949	Johnson	Survey	N/A
	1974	Stonerock	L.C.R.C. L. 6301 P. 615	1" Iron
	1993	Boldt	L.C.R.C. L. 14757 P. 709	3/4" Pipe
	1995	Hart	L.C.R.C. L. 15499 P. 267	3/4" Pipe
	1996	Marini	L.C.R.C. L. 16303 P. 498	3/4" Pipe
	N/A	N/A	O.C. Tax Maps	N/A