

SURVEY & REMONUMENTATION

MAR 04 1998

LIBER 17277PG699

LAND CORNER RECORDATION CERTIFICATE Filing Requirement of Act 74, Mich. P.A. 1970

SECTION

For corners in


Table with columns: Located in: City of Troy, Corner Code #. Rows include Public Land Survey, Property Controlling in Section, Miscellaneous Property in Sec., Lot No., and Private Claims.

Compliance with ACT 345, P.A. 1990

APPROVED ON: 5-2-97 RS OAKLAND COUNTY REMONUMENTATION PEER GROUP COMMITTEE

\$ 7.00 MISCELLANEOUS RECORDING \$ 2.00 REMONUMENTATION 9 JUN 97 12:22 P.M. RECEIPT# 94A PAID RECORDED - OAKLAND COUNTY REGISTERED DEEDS

I, Randy Kolehouse, in a field survey on April 28, 1997, do hereby certify that under requirements of P.A. 74 Michigan P.A. of 1970, the corner points mentioned in lines 1 and 2 above were in conformance with regulations and rules therefore as required in the current manual of survey instructions of the United States Department of the Interior, Bureau of Land Management or by a decree of a Court of Law and/or that the corner points mentioned in lines 3, 4 and 5 above were in conformance with the rules of the Michigan Board of Land Surveyors or by a Decree of a Court of Law; established, re-established, monumented, re-monumented, recovered, found as expressed below:

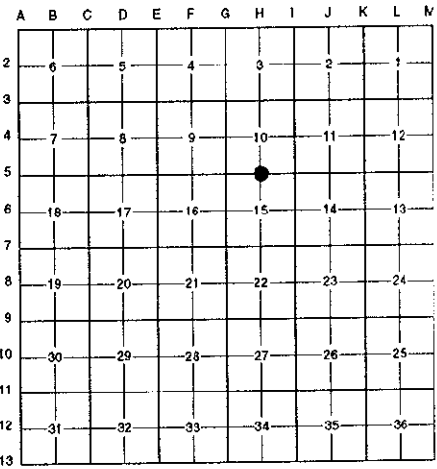

NOTE: Not more than 4 corners, all in the same town and range, may be recorded on this certificate.

A. Description of original monument and accessories and/or subsequent restoration:

Table with columns: H-5, 1817, 1922, 1949, 1972, 1974, 1975, 1975, 1989, N/A; Wampler, Branch, Giffels, N/A, Avendt, Fraus, Fraus, Ward, N/A; G.L.O., Crystal Springs Sub. L. 28 P. 23, Survey, Sylvan Glen Sub. No. 2 L. 132 P. 12-13, L.C.R.C. L. 6401 647, Survey, Survey, L.C.R.C. L. 10857 P. 714-715, O.C. Tax Maps; Set Post, N/A, N/A, N/A, PK Nail & MDSH Tag, N/A, N/A, PK Nail, N/A.

B. Description of corner evidence found and/or method applied in restoring or reestablishing corner:

H-5 Found a railroad spike with "X" cut 0.9' North of the C/L of Long Lake Road (bit.) running East and West on line of a tree row running North per L.C.R.C. L. 10857 P. 714-715 which checks recorded distance 182.15' South of the Southeast corner of Outlet A of Shady Creek Estates Sub. Checks closely distances as shown in recorded plats and surveys of record.

720 FILE 23 ✓

L.C.R.C. L. 10857 P. 714-715 (1989) S 50° E 89.10 Found Iron Rod - 1/2" (m. 89.15')


Measure West 2732.41' to G-5 (G.L.O. = 2683.0') (Sylvan Glen Sub., Sylvan Glen Sub. No. 2 & Shady Creek Est. = 2732.2') Measure East 2642.71' to I-5 (G.L.O. = 2683.0') (Crystal Springs Sub. = 2642.8') (Giffels (1949) = 2644.0')

C. Description of monument for corner and accessories established to perpetuate locating the position of the corner:

H-5 Replaced the railroad spike with a 5/8" x 24" rebar with brass cap stamped "Oakland County Remonumentation P.S. #25854." Also set a new monument box.

- PK Nail & Tag Stamped "Oakland Co. Remonumentation P.S. #25854" in W Side P. Pole North 50.90'
PK Nail & Tag Stamped "Oakland Co. Remonumentation P.S. #25854" in NW Side P. Pole S 40° W 51.63'
PK Nail & Tag Stamped "Oakland Co. Remonumentation P.S. #25854" in E Side 10" Oak S 10° W 43.19'
PK Nail & Tag Stamped "Oakland Co. Remonumentation P.S. #25854" in NE Side 24" Oak S 25° E 59.87'
1/2" Iron Rod S 50° E 89.15'
Concrete Monument North 182.15'

The selected location is accepted by the Contractor and is generally accepted by professional surveyors as the best available evidence of the position of the original corner.

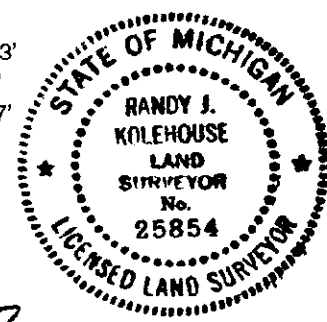

Signed by Randy J. Kolehouse Date 5/23/97

Surveyor's Michigan License No. 25854