

MAR 04 1998

Compliance with ACT 345, P.A. 1990

SECTION

LAND CORNER RECORDATION CERTIFICATE Filing Requirement of Act 74, Mich. P.A. 1970

APPROVED ON: 5-2-97 TS OAKLAND COUNTY REMONUMENTATION PEER GROUP COMMITTEE

For corners in


Table with columns: Oakland (County), Located in: City of Troy, Corner Code #. Rows include Public Land Survey, Property Controlling in Section, and Miscellaneous Property in Sec.

\$ 9.00 MISCELLANEOUS RECORDING \$ 2.00 REMONUMENTATION 9 JUN 97 12:16 P.M. RECEIPT# 94A PAID RECORDED - OAKLAND COUNTY LYNN D. ALLEN, CLERK/REGISTER OF DEEDS

Register of Deeds Stamp & File Number

- 4. Lot No. Recorded Plat
5. Private Claims

I, Randy Kolehouse, in a field survey on March 4 19 97, do hereby certify that under requirements of P.A. 74 Michigan P.A. of 1970, the corner points mentioned in lines 1 and 2 above were in conformance with regulations and rules therefore as required in the current manual of survey instructions of the United States Department of the interior, Bureau of Land Management or by a decree of a Court of Law and/or that the corner points mentioned in lines 3, 4 and 5 above were in conformance with the rules of the Michigan Board of Land Surveyors or by a Decree of a Court of Law; established, re-established, monumented, re-monumented, recovered, found as expressed below:

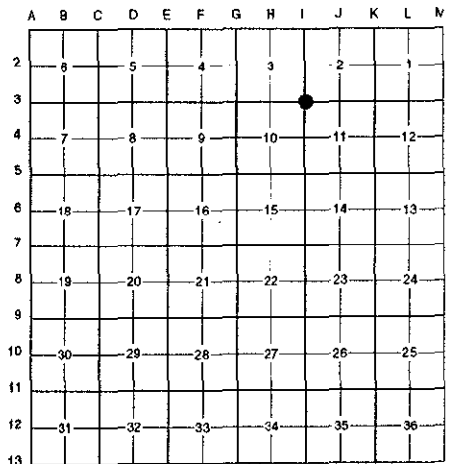

NOTE: Not more than 4 corners, all in the same town and range, may be recorded on this certificate.

A. Description of original monument and accessories and/or subsequent restoration:

Table with columns: I-3, 1817, 1928, 1932, Wampler, Southern, McAlpine, G.L.O. Notes, Survey, Survey, Set Post, N/A, N/A

(Continued on Back)

B. Description of corner evidence found and/or method applied in restoring or reestablishing corner:

I-3 Found a 3/8" rebar set in concrete in a monument box 1' South of the C/L of Square Lake Road (bit.) running East and West and 1' West of the C/L of Rochester Road (conc.) running North and South per an unrecorded Survey by Donnelly and an unrecorded L.C.R.C. by Wilkerson. Also found a 1/2" bar in a monument box N 69° E 1.78'. Checks closely distances as shown in recorded plats and surveys of record.

Unrecorded Survey (1991) (Donnelly) Az. 330° 64.82' Nail & MDSH Tag in SW Face U.P. (m. 64.28')

Unrecorded L.C.R.C. (1993) N 80° E 1.83' Iron in Mon. Box N 33° W 64.27' Nail/Tag S Face U.P. (m. 64.28) S 60° W 75.49' Nail/Tag S Face U.P. (m. 75.39') N 58° W 79.77' C/L Nut on Hydrant S 44° E 67.24' C/L Nut on Hydrant N 69° E 1.78' 1/2" Bar in Mon. Box

Measure North 2237.71' to I-2 (G.L.O. = 2640.0') (Southern (1928) = 2238.11') (Cherryhurst Sub. = 2237.39') Measure South 2991.91' to I-4 (G.L.O. = 2640.0') (Fairway Estates = 2992.49') Measure West 2701.32' to H-3 (G.L.O. = 2677.0') (Golf Estates = 2700.18') Measure East 2647.20' to J-3 (G.L.O. = 2667.7') (Donnelly = 2645.48') (Southern (1928) = 2636.0')


C. Description of monument for corner and accessories established to perpetuate locating the position of the corner:

I-3 Replaced 3/8" rebar with a 5/8" x 24" rebar with brass cap stamped "Oakland County Remonumentation P.S. #25854" in an existing monument box.

PK Nail & Tag Stamped "Oakland Co. Remonumentation P.S. #25854" in SE Face Util. Pole N 40° E 83.15' PK Nail & Tag Stamped "Oakland Co. Remonumentation P.S. #25854" in SW Face Util. Pole S 45° E 63.50' PK Nail & Tag Stamped "Oakland Co. Remonumentation P.S. #25854" in SE Face Util. Pole S 60° W 75.39' PK Nail & Tag Stamped "Oakland Co. Remonumentation P.S. #25854" in S Face Util. Pole N. 32° W 64.28' 1/2" Iron in Mon. Box N 80° E 1.80'

The selected location is accepted by the Contractor and is generally accepted by professional surveyors as the best available evidence of the position of the original corner.

Signed by Randy J. Kolehouse Date 5/29/97 Surveyor's Michigan License No. 25854

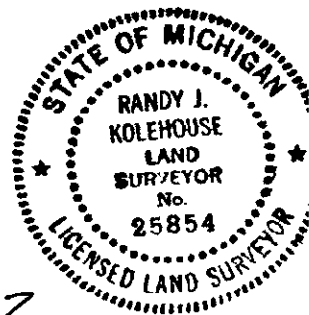

SURVEY &
REMONUMENTATION

LIBER 17277PG654

MAR 04 1998

SECTION

A. Description of original monument and accessories and/or subsequent restoration:

I-3	1947	Clark	Golf Estates L. 58 P. 23	N/A
	1978	Walker	Survey	N/A
	1988	Donnelly	Survey L. 10772 P. 643	N/A
	1988	Ward	L.C.R.C. L. 10844 P. 852-853	Set PK Nail
	1989	Wozniak	The Fairway Estates	N/A
	N/A	Smith	Cherryhurst Sub. L. 209 P. 31	N/A
	1991	Donnelly	Survey	N/A
	1993	Wilkerson	Unrecorded L.C.R.C.	Iron in Mon. Box
	N/A	N/A	O.C. Section Information	N/A
	N/A	N/A	O.C. Tax Maps	N/A

