

**SURVEY & REMONUMENTATION**

MAR 04 1998

LIBER **17325 PG 323**

JUN 24 1997 1 38 PM

**SECTION**

**LAND CORNER RECORDATION CERTIFICATE** 9.00 MISCELLANEOUS RECORDING  
Filing Requirement of Act 74, Mich. P.A. 1970 \$ 2.00 REMONUMENTATION

For corners in

Oakland

(County)

Located in: Troy Twp. Corner Code #

- 1. Public Land Survey      T 2NR 11E      I-12  
    T    R          \_\_\_\_\_  
    T    R          \_\_\_\_\_  
    T    R          \_\_\_\_\_
- 2. Property Controlling    S    T    R          \_\_\_\_\_  
   in Section                S    T    R          \_\_\_\_\_
- 3. Miscellaneous            S    T    R          \_\_\_\_\_  
   Property in Sec.         S    T    R          \_\_\_\_\_

24 JUN 97 3:37 P.M. RECEIPT# 17325  
PAID      RECORDED - OAKLAND COUNTY  
LYNN D. ALLEN, CLERK/REGISTER OF DEEDS

Compliance with  
ACT 345, P.A. 1990

APPROVED ON: 6-5-97 TS  
OAKLAND COUNTY REMONUMENTATION  
PEER GROUP COMMITTEE

Register of Deeds Stamp & File Number

- 4. Lot No. \_\_\_\_\_, Recorded Plat \_\_\_\_\_
- 5. Private Claims \_\_\_\_\_

I, Huston K. Kennedy, in a field survey on 5/9, 19 97 do hereby state that under requirements of P.A. 74, Michigan P.A. of 1970, the corner points mentioned in lines 1 and 2 above were in conformance with regulations and rules therefore as required in the current manual of survey instructions of the United States Department of the Interior, Bureau of Land Management or by a decree of a Court of Law and/or that the corner points mentioned in lines 3, 4 and 5 above were in conformance with the rules of the Michigan Board of Land Surveyors or by a Decree of a Court of Law; established, re-established, monumented, recovered, found as expressed below:

NOTE: Not more than 2 corners, all in the same town and range, may be recorded on this certificate.

	A	B	C	D	E	F	G	H	I	J	K	L	M
1													
2	6		5		4		3		2		1		
3													
4	7		8		9		10		11		12		
5													
6	18		17		16		15		14		13		
7													
8	19		20		21		22		23		24		
9													
10	30		29		28		27		26		25		
11													
12	31		32		33		34		35		36		
13													

- A. Description of original monument and accessories and/or subsequent restoration:  
 1817-GLO Wampler, D.S.; Set Post 9" Beech S22°W 5 Links; 13" Beech N 17 1/2°E 22 Links  
 1.) 1993-Giffels-Webster Engineers, Inc., unrecorded Survey - Object found not stated  
 2.) 1993-Kennedy, PS #17623; unrecorded Survey - Nothing found

- B. Description of corner evidence found and/or method applied in restoring or reestablishing corner:  
 1997 Kennedy Surveying, Inc. - Kennedy, PS #17623 - The corner as recovered falls in a 6 foot high masonry screening wall extending to the East & West, also there is a chain link fence extending to the South.


Field measurements between see back side of LCRC

- C. Description of monument for corner and accessories established to perpetuate locating the position of the corner:  
 I-12 I set a 5/8" x 24" Iron Rod w/2" diameter brass cap stamped Oakland County Remonumentation, PS #17623 as a REFERENCE CORNER 2 feet North of I-12  
 N42°W 60.50' Set PK & Remon Washer NE face Power Pole  
 N31°E 47.25' Center of top bolt of Fire Hydrant  
 N02°W 108.48' SE corner of building #1250F  
 N85°E 90.08' Set PK & Remon Washer NW face 9" Pine

The selected location is accepted by me and is generally accepted by Professional Surveyors as the best available evidence of the position of the reference corner to the original corner.

Signed by [Signature]  
Surveyor's Michigan License No. 12623

Date 6-6-97

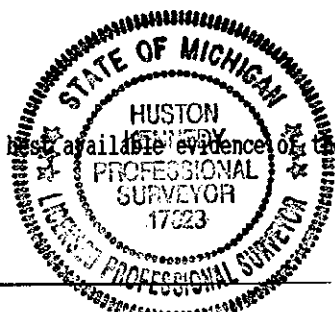

SURVEY &  
REMONUMENTATION

MAR 04 1998

LIBER 173250324

SECTION

FIELD MEASUREMENTS BETWEEN

I-11 to I-12

GLO = 40 chains or 2640.00 Ft.  
Indusco's Oakland Industrial Complex = 2787.00 Ft.  
Giffels-Webster Engineering, Inc., 1993 = 2787.00 Ft.  
GPS-MEA = 2786.67 Ft.

I-12 to I-13

GLO = 40 chains or 2640.00 Ft.  
"GERALDINE HEIGHTS SUBDIVISION" + "BUCKINGHAM ACRES NO. 3" = 2673.95 Ft.  
"BUCKINGHAM ACRES" + "WALT WARY SUBDIVISION" + "KEY WEST SUBDIVISION" = 2673.74 Ft.  
GPS-MEA = 2673.26 Ft.