

SURVEY & REMONUMENTATION

JH - 9 97 | 2 4 4 4 7

MAR 0 4 1998

LIBER 17277PG 659

SECTION LAND CORNER RECORDATION CERTIFICATE Filing Requirement of Act 74, Mich. P.A. 1970

Compliance with ACT 345, P.A. 1990

For corners in


Table with columns: Oakland (County), Located in: City of Troy, Corner Code #. Rows include Public Land Survey, Property Controlling in Section, and Miscellaneous Property in Sec.

APPROVED ON: 3-26-97 FS OAKLAND COUNTY REMONUMENTATION PEER GROUP COMMITTEE

\$ 9.00 MISCELLANEOUS RECORDING \$ 2.00 REMONUMENTATION 9 JUN 97 12:17 P.M. RECEIPT# 94A PAID REGISTERED - OAKLAND COUNTY LYNN D. ALLEN, CLERK/REGISTRAR OF DEEDS Register of Deeds Stamp & File Number

4. Lot No. , Recorded Plat Private Claims

I, Randy Kolehouse, in a field survey on February 5 19 97, do hereby certify that under requirements of P.A. 74 Michigan P.A. of 1970, the corner points mentioned in lines 1 and 2 above were in conformance with regulations and rules therefore as required in the current manual of survey instructions of the United States Department of the Interior, Bureau of Land Management or by a decree of a Court of Law and/or that the corner points mentioned in lines 3, 4 and 5 above were in conformance with the rules of the Michigan Board of Land Surveyors or by a Decree of a Court of Law; established, re-established, monumented, re-monumented, recovered, found as expressed below:

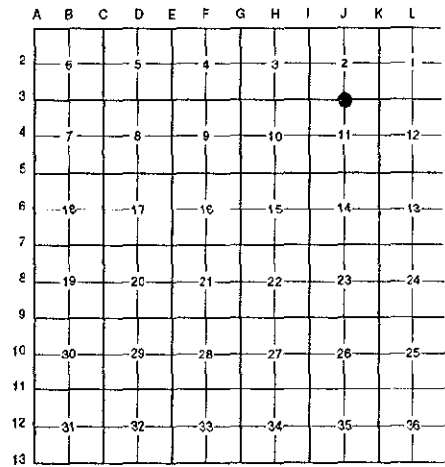

NOTE: Not more than 4 corners, all in the same town and range, may be recorded on this certificate.

A. Description of original monument and accessories and/or subsequent restoration:

J-3 1817 Wampler G.L.O. Set Post 1928 Southern Survey N/A

(Continued on Back)

B. Description of corner evidence found and/or method applied in restoring or reestablishing corner:

J-3 Found a 1/2" iron pipe in a monument box 3.5' North of the C/L of Square Lake Road (bit.) running East and West and 50' West of the C/L of Willow Grove Drive (gravel) on line of a tree and fence line running North per L.C.R.C.'s L. 10844 P. 852, L. 13497 P. 340 and an unrecorded L.C.R.C. by Wilkerson. Checks closely distances as shown in the Oakland County tax records and surveys of record.

L.C.R.C. L. 10844 P. 852-853 (1988) N 13° E 29.85' PK & Washer #21563 E Face U.P. S 45° E 53.28' PK & Washer #21563 NE Face U.P. S 03° E 88.25' PK & Ribbon W Face 28' Elm S 29° W 51.89' C/L Fire Hydrant

Unrecorded L.C.R.C. (1993) N 13° E 29.91' PK/Washer E Face U.P.(m. 29.80') S 52° E 53.34' PK/Washer E Face U.P. (m. 53.20') S 36° W 52.92' Top Nut Hydrant (m. 51.87') S 04° E 88.67' Nail/Tag E Face 30' Elm (m. 88.58')

L.C.R.C. L. 13497 P. 340 (1992) N 05° E 29.80' Nail w/RJD Tag in E Face of P.P. S 50° E 53.27' Nail w/RJD Tag in E Face of P.P. S 45° W 51.87' Center of Fire Hydrant

Measure West 2647.20' to I-3 (G.L.O. = 2667.7') (Donnelly Survey (1991) = 2645.48') (Southern Survey (1928) = 2636.0') (O.C. Tax Map = 2647.27') Measure East 2664.74' to K-3 (G.L.O. = 2667.7') (Southern Survey (1928) = 2664.0')

C. Description of monument for corner and accessories established to perpetuate locating the position of the corner:


J-3 Replaced 1/2" iron pipe with a 5/8" x 24" rebar with brass cap stamped "Oakland County Remonumentation P.S. #25854 in an existing monument box."

PK Nail & Tag Stamped "Oakland Co. Remonumentation P.S. #25854" in E Side Util. Pole N 13° E 29.80' PK Nail & Tag Stamped "Oakland Co. Remonumentation P.S. #25854" in E Face Util. Pole S 25° E 53.20' PK Nail & Tag Stamped "Oakland Co. Remonumentation P.S. #25854" in E Face 30' Elm S 04° E 88.58' Top Nut Hydrant S 36° W 51.87'

The selected location is accepted by the Contractor and is generally accepted by professional surveyors as the best available evidence of the position of the original corner.

Signed by Randy J. Kolehouse Date 5/28/97

Surveyor's Michigan License No. 25854

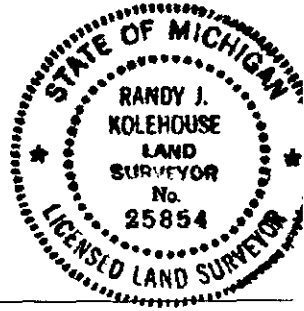

SURVEY &
REMONUMENTATION

MAR 04 1998

LIBER 17277 PG 660

SECTION

A. Description of original monument and accessories and/or subsequent restoration:

J-3	1935	Southern	Survey	N/A
	1937	Baldwin	Survey	N/A
	1946	Giffels	Survey	N/A
	1961	Giffels	Survey	N/A
	1974	N/A	Boundary Survey	N/A
	1988	Ward	L.C.R.C. L. 10844 P. 852-53	PK Nail
	1991	Donnelly	Survey	N/A
	1992	Boldt	L.C.R.C. L. 13497 P. 390	1/2" Pipe in Mon. Box
	1993	Wilkerson	Unrecorded L.C.R.C.	1/2" Pipe in Mon. Box
	1993	N/A	Witnesses	1/2" Pipe in Mon. Box
	N/A	N/A	O.C. Section Information	N/A
	N/A	N/A	O.C. Tax Maps	N/A