

**SURVEY & REMONUMENTATION**

MAR 04 1998

LIBER 17277PG702

JN-997124478

Compliance with ACT 345, P.A. 1990

**LAND CORNER RECORDATION CERTIFICATE**  
Filing Requirement of Act 74, Mich. P.A. 1978

APPROVED ON: 3-26-97  
OAKLAND COUNTY REMONUMENTATION PEER GROUP COMMITTEE

For corners in SECTION


Oakland (County)	Located in:	City of Troy	Corner Code #
1. Public Land Survey	T 2N	R 11E	J-5
	T	R	
	T	R	
	T	R	
2. Property Controlling in Section	S	T	R
	S	T	R
3. Miscellaneous Property in Sec.	S	T	R
	S	T	R

\$ 7.00 MISCELLANEOUS RECORDING  
\$ 2.00 REMONUMENTATION  
9 JUN 97 12:22 P.M. RECEIPT# 94A  
PAID RECORDED - OAKLAND COUNTY  
LYNN D. ALLEN, CLERK/REGISTER OF DEEDS

Register of Deeds Stamp & File Number

4. Lot No. \_\_\_\_\_, Recorded Plat \_\_\_\_\_  
5. Private Claims \_\_\_\_\_

I, Randy Kolehouse, in a field survey on February 5 19 97, do hereby certify that under requirements of P.A. 74 Michigan P.A. of 1970, the corner points mentioned in lines 1 and 2 above were in conformance with regulations and rules therefore as required in the current manual of survey instructions of the United States Department of the Interior, Bureau of Land Management or by a decree of a Court of Law and/or that the corner points mentioned in lines 3, 4 and 5 above were in conformance with the rules of the Michigan Board of Land Surveyors or by a Decree of a Court of Law; established, re-established, monumented, re-monumented, recovered, found as expressed below:

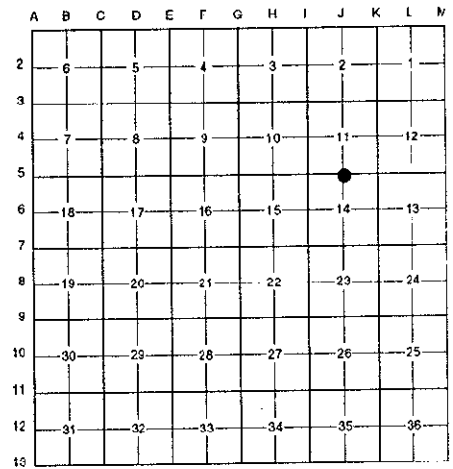

**NOTE: Not more than 4 corners, all in the same town and range, may be recorded on this certificate.**

A. Description of original monument and accessories and/or subsequent restoration:

J-5	1817	Wampler	G.L.O.	Set Post
	1978	Thompson	L.C.R.C. L. 7729 P. 268	PK Nail
	1989	Kohn	Hartford Square Sub. #2	N/A
	1993	Wilkerson	Unrecorded L.C.R.C.	PK Nail
	1993	N/A	Witnesses	PK Nail
	N/A	N/A	O.C. Section Information	N/A
	N/A	N/A	O.C. Tax Maps	N/A

B. Description of corner evidence found and/or method applied in restoring or reestablishing corner:

J-5 Found a PK nail on the C/L of East Long Lake Road (bit.) running East and West per L.C.R.C L. 7729 P. 268 and an unrecorded L.C.R.C. by Wilkerson. Checks closely distances as shown in recorded plats and the Oakland County tax records.

L.C.R.C. L. 7729 P. 268 (1978)  
N 05° W 52.93' PK Nail W Face of D.E. Pole (m. 52.88')  
N 45° E 148.18' PK Nail E Face of D.E. Pole  
S 10° E 102.58' NW corner of house #4989 (m. 102.65')

Unrecorded L.C.R.C. (1993)  
N 03° W 52.93' PK W Face U.P. (m. 52.88')  
N 75° E 148.18' PK E Face U.P.  
S 10° E 102.67' NW Bldg. Cor. Hse. #4989 (m. 102.65')  
S 30° W 77.71' Nail/Tag N Face 4" Maple


Measure West 2640.77' to I-5 (G.L.O. = 2689.5') (Hartford Square Sub. = 2640.88')  
Measure East 2642.44' to K-5 (G.L.O. = 2689.5') (O.C. Tax Map = 2642.23')

700 FILE ✓

C. Description of monument for corner and accessories established to perpetuate locating the position of the corner:

J-5 Replaced PK nail with a 5/8" x 24" rebar with brass cap stamped "Oakland County Remonumentation P.S. #25854." Also set a new monument box.

PK Nail & Tag Stamped "Oakland Co. Remonumentation P.S. #25854" in W Side P. Pole N 03° W 52.88'  
PK Nail & Tag Stamped "Oakland Co. Remonumentation P.S. #25854" in SE Side P. Pole N 75° E 148.18'  
PK Nail & Tag Stamped "Oakland Co. Remonumentation P.S. #25854" in N Side 4" Twin Maple S 30° W 77.71'  
NW Building Cor. House #4989 S 10° E 102.65'

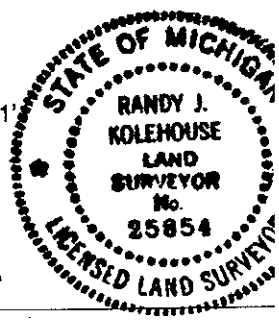

The selected location is accepted by the Contractor and is generally accepted by professional surveyors as the best available evidence of the position of the original corner.

Signed by Randy J. Kolehouse Date 5/28/97  
EARTH TECH

Surveyor's Michigan License No. 25854