

SURVEY & REMONUMENTATION

LIBER 17156PG246

MAR 04 1998

LAND CORNER RECORDATION CERTIFICATE
Filing Requirement of Act 74, Mich. P.A. 1970

For corners in SECTION

Oakland (County) Located In: Troy Twp. Corner Code #

1. Public Land Survey	T <u>2N</u> R <u>11E</u>	J-11
	T <u> </u> R <u> </u>	
	T <u> </u> R <u> </u>	
	T <u> </u> R <u> </u>	
2. Property Controlling in Section	S <u> </u> T <u> </u> R <u> </u>	
	S <u> </u> T <u> </u> R <u> </u>	
3. Miscellaneous Property in Sec.	S <u> </u> T <u> </u> R <u> </u>	
	S <u> </u> T <u> </u> R <u> </u>	

\$ 9.00 MISCELLANEOUS RECORDING
 \$ 2.00 REMONUMENTATION
 24 APR 97 8:43 A.M. RECEIPT# 544
 PAID RECORDED - OAKLAND COUNTY
 LYNN D. ALLEN, CLERK/REGISTER OF DEEDS

Compliance with ACT 345, P.A. 1999
 APPROVED ON: 4-16-97 JS
 OAKLAND COUNTY REMONUMENTATION PEER GROUP COMMITTEE
 Register of Deeds Stamp & File Number

4. Lot No. _____, Recorded Plat _____
 5. Private Claims _____

I, Huston K. Kennedy, in a field survey on 3/7, 1997 do hereby state that under requirements of P.A. 74, Michigan P.A. of 1970, the corner points mentioned in lines 1 and 2 above were in conformance with regulations and rules therefore as required in the current manual of survey instructions of the United States Department of the Interior, Bureau of Land Management or by a decree of a Court of Law and /or that the corner points mentioned in lines 3, 4 and 5 above were in conformance with the rules of the Michigan Board of Land Surveyors or by a Decree of a Court of Law; established, re-established, monumented, recovered, found as expressed below:

A	B	C	D	E	F	G	H	I	J	K	L	M
1												
2	6	5	4	3	2	1						
3												
4	7	8	9	10	11	12						
5												
6	18	17	16	15	14	13						
7												
8	19	20	21	22	23	24						
9												
10	30	29	28	27	26	25						
11												
12	31	32	33	34	35	36						
13												

NOTE: Not more than 2 corners, all in the same town and range, may be recorded on this certificate.

- A. Description of original monument and accessories and/or subsequent restoration:
 1817-GLO Wampler, D.S.; Set Post 23" Red Oak N59°E 11 Links; 14" Lynn S88°W 14 Links
 1.) 1978-Parish, PS #24609; LCRC L.7129, Pg.758 - Fnd P.K. Nail
 2.) 1990-Marini, PS #26462; LCRC L.11452, Pg.042 - Fnd 5/8" Rerod (Should be recorded for L-9)
 3.) 1992-Donnelly, PS #21563; LCRC L.12283, Pg.216 - Fnd 3/4" Iron Rod in a Monument Box
 4.) 1975-Patterson, PS #17631; Survey Liber & Page unreadable - Object found not stated, no witnesses
 5.) 1991-City of Troy witnesses - Fnd 1" Iron in a Monument Box
 6.) 1993-Marini, PS #26462; Unrecorded Survey; - Object found not stated, no witnesses

B. Description of corner evidence found and/or method applied in restoring or reestablishing corner:
 1997 Kennedy Surveying, Inc. - Kennedy, PS #17623 - Fnd 1" Iron Rod in a Monument Box in the center of the left turn lane for Maple Road extending East & West, which has a concrete surface. There is a fence/tree row extending to the North & South, also 90 feet West of the West edge of a overpass for I-75.
 Witnesses from LCRC #2 & City of Troy unrecorded witnesses were used to recover and verify the location of the found 1" Iron Rod in a Monument Box.


I accepted the found 1" Iron Rod in a Monument Box as the best evidence of the original corner position.
 Field measurements between see back side of LCRC

C. Description of monument for corner and accessories established to perpetuate locating the position of the corner:
 J-11 I replaced the found 1" Iron Rod with a 5/8" x 24" Iron Rod w/2" diameter brass cap stamped Oakland County Remonumentation, PS #17623 in a existing Monument Box
 N05°W 41.96' Set PK & Remon Washer East face Power Pole
 N52°E 85.85' NW corner of concrete pier
 S52°E 85.85' SW corner of concrete pier
 S61°W 73.07' Center of top bolt on fire hydrant

The selected location is accepted by me and is generally accepted by Professional Surveyors as the best available evidence of the position of the original corner.

Signed by [Signature]
 Surveyor's Michigan License No. 17623

Date 4-17-97

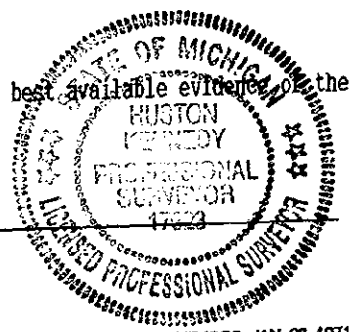

7A
SURVEY &
REMONUMENTATION

LIBER 17156 PG 247

MAR 04 1998

SECTION

FIELD MEASUREMENTS BETWEEN

J-11 to I-11

GLO = 37.56 chains or 2610.96 Ft.
Indusco's Oakland Industrial Complex = 2650.81 Ft.
Robert J. Patterson, PS #17631 (11/20/75) = 2646.19 Ft.
Nicola Marina, PS #26462 (7/29/93) = 2650.94 Ft.
GPS-MEA = 2650.37 Ft.

J-11 to K-11

GLO = 39.56 chains or 2610.96 Ft.
"SUPERVISOR'S PLAT NO. 21" + "SUPERVISOR'S PLAT NO. 30" + "JOHN R GARDENS" = 2592.85 Ft.
"CAMBRIDGE HEIGHTS" + SUPERVISOR'S PLAT NO. 29" + Parcels = 2591.50 Ft.
GPS-MEA = 2592.97 Ft.