

MAR 04 1998

LAND CORNER RECORDATION CERTIFICATE
Filing Requirement of Act 74, Mich. P.A. 1970

Compliance with ACT 345, P.A. 1990

For corners in SECTION

Oakland (County)


Located in: City of Troy Corner Code #

- 1. Public Land Survey T 2N R 11E K-2
2. Property Controlling in Section S T R
3. Miscellaneous Property in Sec. S T R

APPROVED ON: 3-26-97 RS
OAKLAND COUNTY REMONUMENTATION PEER GROUP COMMITTEE

\$ 9.00 MISCELLANEOUS RECORDING
\$ 2.00 REMONUMENTATION
9 JUN 97 12:17 P.M. RECEIPT# 94A
PAID RECORDED - OAKLAND COUNTY
LYNN D. ALLEN, CLERK/REGISTER OF DEEDS
Register of Deeds Stamp & File Number

- 4. Lot No. , Recorded Plat
5. Private Claims

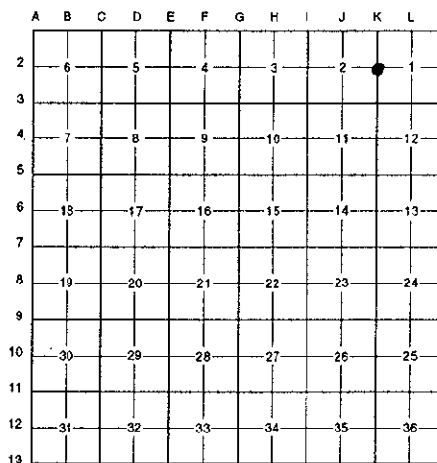

I, Randy Kolehouse, in a field survey on February 6 19 97, do hereby certify that under requirements of P.A. 74 Michigan P.A. of 1970, the corner points mentioned in lines 1 and 2 above were in conformance with regulations and rules therefore as required in the current manual of survey instructions of the United States Department of the interior, Bureau of Land Management or by a decree of a Court of Law and/or that the corner points mentioned in lines 3, 4 and 5 above were in conformance with the rules of the Michigan Board of Land Surveyors or by a Decree of a Court of Law; established, re-established, monumented, re-monumented, recovered, found as expressed below:

NOTE: Not more than 4 corners, all in the same town and range, may be recorded on this certificate.

A. Description of original monument and accessories and/or subsequent restoration:

Table with 4 columns: K-2, 1817, Wampler, G.L.O. Notes, Set Post. Rows include 1927 Baldwin, 1928 Southern, 1928 Southern.

(Continued on Back)

B. Description of corner evidence found and/or method applied in restoring or reestablishing corner:

K-2 Found a PK nail 2' +/- West of the C/L of John R. Road (bit.) running North and South and 100' +/- South of the C/L of Atkins Drive (bit.) running West per L.C.R.C.'s L. 7095 P. 397, L. 12937 P. 474, and an unrecorded L.C.R.C. by Wilkerson. Checks closely distances as shown in recorded plats and surveys of record.

- L.C.R.C. L. 7095 P. 397 (1977) S 45° E 59.18' N&C in P.P.
Unrecorded L.C.R.C. (1993) N 27° W 77.73' Cut Cross SE Rim Storm M.H.
S 31° E 58.50' PK Nail in P.P.
L.C.R.C. L. 12937 P. 474 (1990) N 30° W Cross in SE Rim of Storm M.H.
S 36° W 58.44' Nail with Tag #28400 N Face of U.P.
N 20° E 116.70' Nail/Tag W Face P.P.
S 77° W 68.98' Cut "X" NE Face L.P.

Handwritten note: C. J. FILE

Measure North 3651.10' to K-1 (G.L.O. = 3428.0') (Donnelly Survey = 3650.3') (Southern = 3639.0')
Measure South 2299.92' to K-3 (G.L.O. = 2640.0') (Southern (1928) = 2292.0')
(Square Lake Place Sub. No. 2 = 2299.94') (Baldwin (1927) = 2299.98')


C. Description of monument for corner and accessories established to perpetuate locating the position of the corner:

K-2 Replaced PK nail with a 5/8" x 24" rebar with brass cap stamped "Oakland County Remonumentation P.S. #25854." Also set a new monument box.

- PK Nail & Tag Stamped "Oakland Co. Remonumentation P.S. #25854" in N Side P. Pole S 31° E 58.50'
PK Nail & Tag Stamped "Oakland Co. Remonumentation P.S. #25854" in W Side P. Pole N 20° E 116.70'
"X" Cut in SE Rim Storm M.H. N 27° W 77.73'
"X" Cut in SE Corner L. Pole Base S 77° W 68.98'

The selected location is accepted by the Contractor and is generally accepted by professional surveyors as the best available evidence of the position of the original corner.

Signed by Randy J. Kolehouse Date 5/20/97
EARTH TECH
Surveyor's Michigan License No. 25854

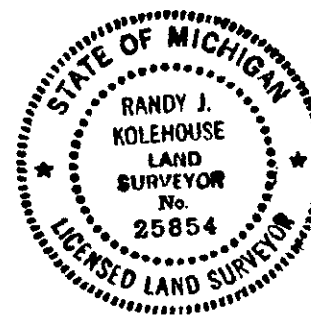

SURVEY &
REMONUMENTATION

FIBER 172770664

MAR 04 1998

SECTION

A. Description of original monument and accessories and/or subsequent restoration:

K-2	1928	Southern	Survey	N/A
	1932	Southern	Survey	N/A
	1950	N/A	Plat of Survey	N/A
	1977	Stonerock	L.C.R.C. L. 7095 P. 397	PK Nail
	1980	Pawlaczyk	Survey L. 7897 P. 224	N/A
	1980	Pawlaczyk	L.C.R.C. L. 786 P. 3	N/A
	1983	Giffels	Survey	N/A
	1987	Zelmet	Square Lake Place Sub. #2 L. 194 P. 1	N/A
	1990	Marini	L.C.R.C. L. 12937 P. 474	PK Nail
	1993	Wilkerson	Unrecorded L.C.R.C.	PK Nail
	1994	Donnelly	Survey	N/A
	N/A	N/A	O.C. Section Information	N/A
	N/A	N/A	O.C. Tax Maps	N/A

