

MAR 04 1998

Compliance with ACT 345, P.A. 1990

LAND CORNER RECORDATION CERTIFICATE Filing Requirement of Act 74, Mich. P.A. 1970

APPROVED ON: 3-26-97 FS OAKLAND COUNTY REMONUMENTATION PEER GROUP COMMITTEE

SECTION


For corners in

Table with columns: Oakland (County), Located in: City of Troy, Corner Code #. Rows include Public Land Survey, Property Controlling in Section, and Miscellaneous Property in Sec.

\$ 9.00 MISCELLANEOUS RECORDING \$ 2.00 REMONUMENTATION 9 JUN 97 12:17 P.M. RECEIPT# 94A PAID RECORDED - OAKLAND COUNTY LYNN D. ALLEN, CLERK/REGISTER OF DEEDS

Register of Deeds Stamp & File Number

- 4. Lot No. , Recorded Plat Private Claims

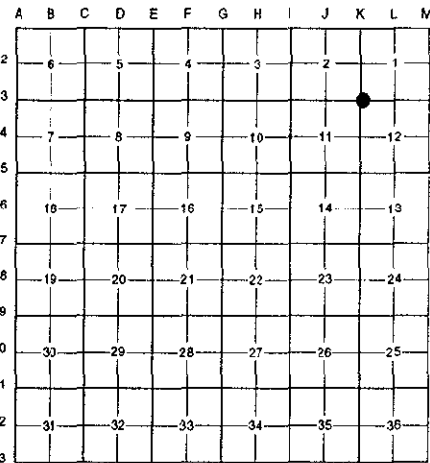

I, Randy Kolehouse, in a field survey on March 4 19 97, do hereby certify that under requirements of P.A. 74 Michigan P.A. of 1970, the corner points mentioned in lines 1 and 2 above were in conformance with regulations and rules therefore as required in the current manual of survey instructions of the United States Department of the Interior, Bureau of Land Management or by a decree of a Court of Law and/or that the corner points mentioned in lines 3, 4 and 5 above were in conformance with the rules of the Michigan Board of Land Surveyors or by a Decree of a Court of Law; established, re-established, monumented, re-monumented, recovered, found as expressed below:

NOTE: Not more than 4 corners, all in the same town and range, may be recorded on this certificate.

A. Description of original monument and accessories and/or subsequent restoration:

Table with columns: K-3, 1817, Wampler, G.L.O. Notes, Set Post. Rows include 1927 Baldwin Survey N/A and 1928 Southern Survey N/A.

(Continued on Back)

B. Description of corner evidence found and/or method applied in restoring or reestablishing corner:

K-3 Found a 1/2" rebar in a monument box at the C/L intersection of John R. Road (bit.) running North and South and East Square Lake Road (bit.) running East and West per L.C.R.C. L. 13497 P. 392 and an unrecorded L.C.R.C. by Wilkerson. Checks closely distances as shown in recorded plats, Oakland County tax records and surveys of record.

Table with columns: L.C.R.C. L. 13497 P. 392 (1992), Unrecorded L.C.R.C. (1993). Rows include bearings and distances for various monuments like Nail with City of Troy Tag, Top Nut on Hydrant, and Nail/Tag NW Face U.P.

Measure North 2299.92' to K-2 (G.L.O. = 2640.0') (Southern (1932) = 2295.0') (Baldwin (1927) = 2299.98') (Sq. Lake Place Sub No. 2 = 2299.94') Measure South 2981.43' to K-4 (G.L.O. = 2640.0') (Southern (1930) = 2982.3') Measure West 2664.74' to J-3 (G.L.O. = 2667.7') (Southern (1928) = 2664.0') Measure East 2646.47' to L-3 (G.L.O. = 2635.4') (Nowak & Fraus = 2646.34') (Sq. Lake Place Sub = 2646.5')


900 file 200 ✓

C. Description of monument for corner and accessories established to perpetuate locating the position of the corner:

K-3 Replaced 1/2" rebar with a 5/8" x 24" rebar with brass cap stamped "Oakland County Remonumentation P.S. #25854 in an existing monument box."

PK Nail & Tag Stamped "Oakland Co. Remonumentation P.S. #25854" in NW Side Util. Pole N 54° E 52.42' PK Nail & Tag Stamped "Oakland Co. Remonumentation P.S. #25854" in SW Side Util. Pole N 25° W 64.30' PK Nail & Tag Stamped "Oakland Co. Remonumentation P.S. #25854" in W Side Util. Pole S 27° E 71.82' Top Nut of Hyd. S 59° W 84.10'

The selected location is accepted by the Contractor and is generally accepted by professional surveyors as the best available evidence of the position of the original corner.

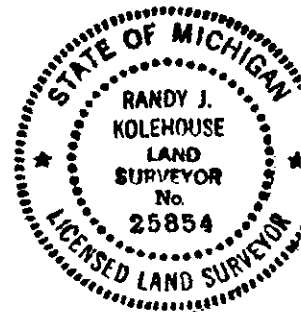

Signed by Randy J. Kolehouse Date 5/28/97 Surveyor's Michigan License No. 25854

SURVEY &
REMONUMENTATION

LIBER 17277 PG 666

MAR 04 1998

SECTION


A. Description of original monument and accessories and/or subsequent restoration:

K-3	1930	Southern	Survey	N/A
	1932	Southern	Survey	N/A
	1977	Stonerock	L.C.R.C. L. 7095 P. 397	PK Nail
	1983	Giffels	Survey	N/A
	1984	Nowak & Fraus	Topographic Survey	N/A
	1986	Ziomet	Square Lake Place Sub. L. 189 P. 20	N/A
	1987	Ziomet	Square Lake Place Sub. No. 2 L. 194 P. 1	N/A
	1991	Kennedy	L.C.R.C. L. 12168 P. 644	1/2" Iron Pipe
	1992	Boldt	L.C.R.C. L. 13497 P. 392	1/2" Rerod
	1993	Wilkerson	Unrecorded L.C.R.C.	1/2" Iron Rod
	1993	OHM	Witness Records	1/2" Iron Rod in Mon. Box
	N/A	McGinnis	Survey	N/A
	N/A	N/A	O.C. Section Information	N/A
	N/A	N/A	O.C. Tax Maps	N/A

