

SURVEY & REMONUMENTATION

LIBER 17217PG471

LAND CORNER RECORDATION CERTIFICATE
Filing Requirement of Act 74, Mich. P.A. 1970

MAR 04 1998

For corners in

Oakland SECTION Located in: Troy Twp. Corner Code #
(County)

- 1. Public Land Survey T 2N R 11E K-12
T R
T R
T R
- 2. Property Controlling S T R
in Section S T R
- 3. Miscellaneous S T R
Property in Sec. S T R

\$ 9.00 MISCELLANEOUS RECORDING
\$ 2.00 REMONUMENTATION
19 MAY 97 7:45 A.M. RECEIPT# 11A
PAID RECORDED - OAKLAND COUNTY
LYNN D. ALLEN, CLERK/REGISTER OF DEEDS

Compliance with
ACT 345, P.A. 1990

APPROVED ON: 5-9-97 TS
OAKLAND COUNTY REMONUMENTATION
PEER GROUP COMMITTEE
Register of Deeds Stamp & File Number

- 4. Lot No. _____, Recorded Plat _____
- 5. Private Claims _____

I, Huston K. Kennedy, in a field survey on 5-2, 1997 do hereby state that under requirements of P.A. 74, Michigan P.A. of 1970, the corner points mentioned in lines 1 and 2 above were in conformance with regulations and rules therefore as required in the current manual of survey instructions of the United States Department of the Interior, Bureau of Land Management or by a decree of a Court of Law and /or that the corner points mentioned in lines 3, 4 and 5 above were in conformance with the rules of the Michigan Board of Land Surveyors or by a Decree of a Court of Law; established, re-established, monumented, recovered, found as expressed below:

NOTE: Not more than 2 corners, all in the same town and range, may be recorded on this certificate.

	A	B	C	D	E	F	G	H	I	J	K	L	M
1													
2	6		5		4		3		2		1		
3													
4	7		8		9		10		11		12		
5													
6	18		17		16		15		14		13		
7													
8	19		20		21		22		23		24		
9													
10	30		29		28		27		26		25		
11													
12	31		32		33		34		35		36		
13													

A. Description of original monument and accessories and/or subsequent restoration:
1817-GLO Wampler, D.S.; Set Post 8" Elm S82°E 19 Links' 11" Elm S79°W 25 Links

B. Description of corner evidence found and/or method applied in restoring or reestablishing corner:
1997 Kennedy Surveying, Inc. - Kennedy, PS #17623 - Fnd 1/2" Iron Rod 14" below the surface and is located in the center of the median of John R. Road extending to the North & South, which has a concrete surface. The corner is 30 feet South of the existing centerline of Lovington Avenue extending to the East, which has a concrete surface, also there is a plat extending to the West.


Field measurements between see back side of LCRC

C. Description of monument for corner and accessories established to perpetuate locating the position of the corner:
K-12 I replaced the found 1/2" Iron Rod w/4" diameter concrete monument with 1/2" Iron Rod 36" long w/2" diameter brass cap stamped Oakland County Remonumentation, PS #17623
N81°W 148.05' SE corner of building #777
S75°W 188.00' NE corner of building #735
N42°E 166.48' SW corner of building #2003
S40°E 105.03' Set PK & Remon Washer SW face Power Pole
Due West 75.06 feet found 1/2" Iron Rod

The selected location is accepted by me and is generally accepted by Professional Surveyors as the best available evidence of the position of the original corner.

Signed by [Signature]
Surveyor's Michigan License No. 17623

Date 5-8-97

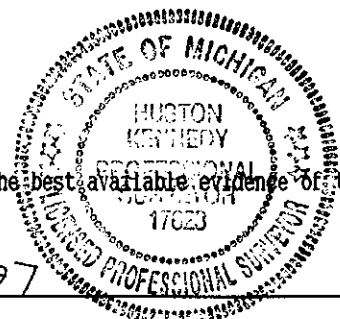

SURVEY &
REMONUMENTATION

EISER 17217PG472

MAR 04 1998

SECTION

FIELD MEASUREMENTS BETWEEN

K-11 to K-12

GLO = 40 chains or 2640.00 Ft.

Parcels + "RING INDUSTRIAL PARK" = 2832.85 Ft.

GPS-MEA = 2833.20 Ft.

K-12 to K-13

GLO = 40 chains or 2640.00 Ft.

GPS-MEA 2833.20 Ft.