

MAR 04 1998

LAND CORNER RECORDATION CERTIFICATE
Filing Requirement of Act 74, Mich. P.A. 1970

Compliance with ACT 345, P.A. 1990

For corners in

SECTION

Table with columns: Oakland (County), Located in: City of Troy, Corner Code #. Rows include Public Land Survey, Property Controlling in Section, Miscellaneous Property in Sec., Lot No., and Private Claims.

APPROVED ON: 3-26-97 TS
OAKLAND COUNTY REMONUMENTATION PEER GROUP COMMITTEE

\$ 9.00 MISCELLANEOUS RECORDING
\$ 2.00 REMONUMENTATION
9 JUN 97 12:17 P.M. RECEIPT# 94A
PAID RECORDED - OAKLAND COUNTY
LYNN D. ALLEN, CLERK/REGISTER OF DEEDS
Register of Deeds Stamp & File Number

I, Randy Kolehouse, in a field survey on February 5, 1997, do hereby certify that under requirements of P.A. 74 Michigan P.A. of 1970, the corner points mentioned in lines 1 and 2 above were in conformance with regulations and rules therefore as required in the current manual of survey instructions of the United States Department of the interior, Bureau of Land Management or by a decree of a Court of Law and/or that the corner points mentioned in lines 3, 4 and 5 above were in conformance with the rules of the Michigan Board of Land Surveyors or by a Decree of a Court of Law; established, re-established, monumented, re-monumented, recovered, found as expressed below:

NOTE: Not more than 4 corners, all in the same town and range, may be recorded on this certificate.

A. Description of original monument and accessories and/or subsequent restoration:

Table with columns: L-3, 1817, 1940, N/A, 1963, Wampler, Lehner, MCS, N/A, G.L.O. Notes, Supervisors Plat of Wilbrett Acres L. 13 P. 54, Survey, Section Corners Ties, Set Post, N/A, N/A, 3/4" Pipe

(Continued on Back)

B. Description of corner evidence found and/or method applied in restoring or reestablishing corner:

L-3 Found a 1/2" rebar with an illegible cap in a monument box 3' North of the C/L of Square Lake Road (bit.) running East and West, 24' East of a fence line running South, and 33' ± East of a fence line running North per L.C.R.C.'s L. 7095 P. 397, L. 10956 P. 331, L. 12168 P. 644, L. 13497 P. 393 and an unrecorded L.C.R.C. by Wilkerson. Checks closely distances as shown in recorded plats and surveys of record.

L.C.R.C. L. 7095 P. 397 (1977) S 40° W 80.10' N&C in P.P.
L.C.R.C. L. 13497 P. 393 (1992) S 50° W 80.10' Nail w/Tag RLS #17623 NW Face of P.P. (m. 80.18')
S 60° E 135.69' Nail w/Tag #30090 N Face P.P. (m. 135.65')
S 45° E 65.65' Center of Top Nut of Hyd. #12-5 (m. 65.72')

L.C.R.C. L. 10956 P. 331 (1988) S 40° E 65.71' Top Bolt of Fire Hyd. (m. 65.72')
S 40° W 80.11' NW NW Face P.P.

Measure West 2646.47' to K-3 (G.L.O. = 2635.38') (Square Lake Place Sub. = 2646.5')
(Nowak & Fraus = 2646.34') (Square Lake Place Sub. = 2646.49')
Measure East 2592.05' to M-3 (G.L.O. = 2635.38') (Shariwoods Sub. = 2592.21') (Hidden Stone Sub. = 2592.14')
(Stoneridge Sub. & Sup. Plat Wilbrett Acres = 2591.87')



C. Description of monument for corner and accessories established to perpetuate locating the position of the corner:

L-3 Replaced 1/2" rebar with a 5/8" x 24" rebar with brass cap stamped "Oakland County Remonumentation P.S. #25854" in an existing monument box.

PK Nail & Tag Stamped "Oakland Co. Remonumentation P.S. #25854" in N Side P. Pole S 60° E 135.65'
PK Nail & Tag Stamped "Oakland Co. Remonumentation P.S. #25854" in NW Side P. Pole S 49° W 80.18'
PK Nail & Tag Stamped "Oakland Co. Remonumentation P.S. #25854" in N Side 6" Maple S 74° E 101.08'
1/2" Rebar (Property Corner) N 25° W 69.63'
Top of Hydrant S 30° E 65.72'

The selected location is accepted by the Contractor and is generally accepted by professional surveyors as the best available evidence of the position of the original corner.

Signed by Randy J. Kolehouse Date 5/28/97
EARTH TECH
Surveyor's Michigan License No. 25854

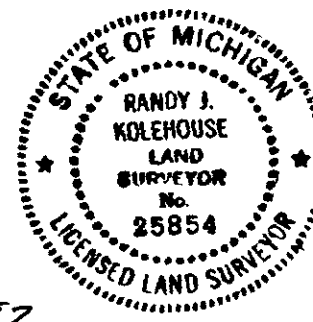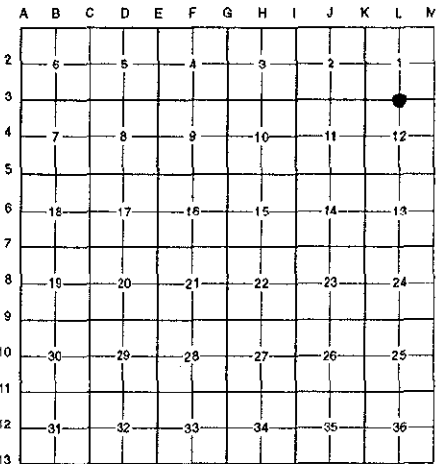

SURVEY &  
REMONUMENTATION

LIBER 17277 PG 674

MAR 04 1998

SECTION

A. Description of original monument and accessories and/or subsequent restoration:

L-3	N/A	N/A	Stoneridge Sub. L. 134 P. 35	N/A
	1973	Ross	L.C.R.C. L. 7533 P. 838	R.R. Spike
	1977	Stonerock	L.C.R.C. L. 7095 P. 397	1" Pipe
	1984	Nowak & Fraus	Survey	N/A
	1986	Zeimet	Square Lake Place Sub. L. 189 P. 20	N/A
	1988	Kennedy	Survey	N/A
	1988	Kennedy	L.C.R.C. L. 10956 P. 331	PK Nail
	1991	Graham	Hidden Stone Sub. L. 218 P. 21	N/A
	1991	Kennedy	Shariwoods Sub. L. 223 P. 26	N/A
	1991	Kennedy	L.C.R.C. L. 12168 P. 644	PK Nail
	1992	Boldt	L.C.R.C. L. 13497 P. 393	Set 1/2" Rerod
	1993	Wilkerson	Unrecorded L.C.R.C.	1/2" Iron Rod
	N/A	N/A	O.C. Section Information	N/A
	N/A	N/A	O.C. Tax Maps	N/A