

MAR 04 1998

LIBER 17156 PG 260

SECTION

LAND CORNER RECORDATION CERTIFICATE
Filing Requirement of Act 74, Mich. P.A. 1970

For corners in

Oakland

(County)

Located In: Troy Twp. Corner Code #

- 1. Public Land Survey T 2N R 11E L-9
- T R
- T R
- T R
- 2. Property Controlling S T R
- in Section S T R
- 3. Miscellaneous S T R
- Property in Sec. S T R

\$ 9.00 MISCELLANEOUS RECORDING
 \$ 2.00 REMONUMENTATION
 24 APR 97 8:47 A.M. RECEIPT# 55A
 PAID RECORDED - OAKLAND COUNTY
 LYNN D. ALLEN, CLERK/REGISTER OF DEEDS

Compliance with
 ACT 345, P.A. 1990

APPROVED ON: 3-25-97 TS
 OAKLAND COUNTY REMONUMENTATION
 PEER GROUP COMMITTEE

Register of Deeds Stamp & File Number

4. Lot No. _____, Recorded Plat _____
 5. Private Claims _____

I, Huston K. Kennedy, in a field survey on 1/26, 19 97 do hereby state that under requirements of P.A. 74, Michigan P.A. of 1970, the corner points mentioned in lines 1 and 2 above were in conformance with regulations and rules therefore as required in the current manual of survey instructions of the United States Department of the Interior, Bureau of Land Management or by a decree of a Court of Law and/or that the corner points mentioned in lines 3, 4 and 5 above were in conformance with the rules of the Michigan Board of Land Surveyors or by a Decree of a Court of Law; established, re-established, monumented, recovered, found as expressed below:

NOTE: Not more than 2 corners, all in the same town and range, may be recorded on this certificate.

	A	B	C	D	E	F	G	H	I	J	K	L	M
1													
2		6		5		4		3		2		1	
3													
4		7		8		9		10		11		12	
5													
6		18		17		16		15		14		13	
7													
8		19		20		21		22		23		24	
9													
10		30		29		28		27		26		25	
11													
12		31		32		33		34		35		36	
13													

A. Description of original monument and accessories and/or subsequent restoration:
 1817-GLO Wampler, D.S.; Set Post 8" Birch S82°W 15 Links; 11" Elm N70°E 13 Links
 1.) 1989-Donnelly, PS #21563; LCRC L.11062, Pg.217 - Fnd a P.K. Nail
 2.) 1991-Marini, PS #26462; LCRC L.12173, Pg.265 - Fnd a 1/2" Iron
 3.) Branch, PS Unrecorded Survey - Object found not stated, no witnesses

B. Description of corner evidence found and/or method applied in restoring or reestablishing corner:
 1997 Kennedy Surveying, Inc. - Kennedy, PS #17623 - The corner has not been perpetuated due to the widening of Big Beaver Road. The corner was recovered by using LCRC's recorded in Liber 11062, Page 217 & Liber 12173, Page 265 of Oakland County Records.

Witnesses from LCRC #1, 2 were used to recover and verify the location of the recovered corner.

I accepted the corner as recovered as the best evidence of the original corner position.

Field measurements between see back side of LCRC


C. Description of monument for corner and accessories established to perpetuate locating the position of the corner:

L-9 I set a 4" diameter Concrete Monument with 1/2" Iron Rod 36" long w/2" diameter brass cap stamped Oakland County Remonumentation, PS #17623
 N43°W 143.29' Set PK & Remon Washer NE face 14" Maple
 N03°W 159.10' Set PK & Remon Washer East face Power Pole
 N48°E 147.09' SW corner of house #2515
 S02°E 147.27' Set PK & Remon Washer West face Power Pole
 South 60.23 Ft. Fnd 1/2" Iron Rod

The selected location is accepted by me and is generally accepted by Professional Surveyors as the best available evidence of the position of the original corner.

Signed by [Signature]
 Surveyor's Michigan License No. 17623

Date 3/28/97

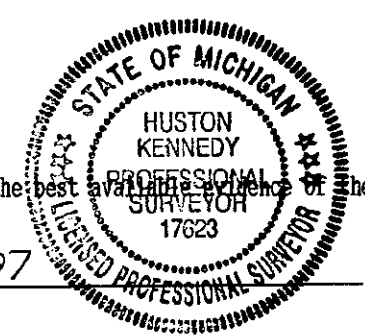

SURVEY &
REMONUMENTATION

MAR 04 1998

SECTION

LIBER 17156 PG 261

FIELD MEASUREMENTS BETWEEN

L-9 to K-9

GLO = 39.74 chains or 2622.84 Ft.
M.C.S. 2608.77 Ft. No date stated
"BIG BEAVER POULTRY FARM" = 2609.80 Ft.
GPS-MEA = 2609.33 Ft.

L-9 to M-9

GLO = 39.74 chains or 2622.84 Ft.
M.C.S. 2646.06 Ft. No date stated
"BEAVER TRAIL SUBDIVISION" + "GOLDEN GATE SQUARE SUBDIVISION" + Parcels = 2646.42 Ft.
"MOREL EAST SUBDIVISION" = 2646.40
GPS-MEA = 2646.44