

SURVEY & REMONUMENTATION

MAR 04 1998

LIBER 172770675

LAND CORNER RECORDATION CERTIFICATE
Filing Requirement of Act 74, Mich. P.A. 1970

Compliance with ACT 345, P.A. 1990

For corners in SECTION

_____ Oakland _____ (County)	Located in:	City of Troy	Corner Code #
1. Public Land Survey	T <u>2N</u>	R <u>11E</u>	<u>M-1</u>
	T _____	R _____	_____
	T _____	R _____	_____
	T _____	R _____	_____
2. Property Controlling in Section	S _____	T _____	R _____
	S _____	T _____	R _____
3. Miscellaneous Property in Sec.	S _____	T _____	R _____
	S _____	T _____	R _____

APPROVED ON: 3-26-97 RS
OAKLAND COUNTY REMONUMENTATION PEER GROUP COMMITTEE

\$ 9.00 MISCELLANEOUS RECORDING
\$ 2.00 REMONUMENTATION
9 JUN 97 12:18 P.M. RECEIPT# 94A
PAID RECORDED - OAKLAND COUNTY
LYNN D. ALLEN, CLERK/REGISTER OF DEEDS
Register of Deeds Stamp & File Number

- 4. Lot No. _____, Recorded Plat _____
- 5. Private Claims _____

	A	B	C	D	E	F	G	H	I	J	K	L	M
2	6		5		4		3		2		1		
3													
4	7		8		9		10		11		12		
5													
6	18		17		16		15		14		13		
7													
8	19		20		21		22		23		24		
9													
10	30		29		28		27		26		25		
11													
12	31		32		33		34		35		36		
13													

I, Randy Kolehouse, in a field survey on March 5 19 97, do hereby certify that under requirements of P.A. 74 Michigan P.A. of 1970, the corner points mentioned in lines 1 and 2 above were in conformance with regulations and rules therefore as required in the current manual of survey instructions of the United States Department of the Interior, Bureau of Land Management or by a decree of a Court of Law and/or that the corner points mentioned in lines 3, 4 and 5 above were in conformance with the rules of the Michigan Board of Land Surveyors or by a Decree of a Court of Law; established, re-established, monumented, re-monumented, recovered, found as expressed below:

NOTE: Not more than 4 corners, all in the same town and range, may be recorded on this certificate.

A. Description of original monument and accessories and/or subsequent restoration:

M-1 1816 Wampler G.L.O. Notes Set Post
1987 Donnelly L.C.R.C. L. 11062 P. 219 1" Iron Bar

(Continued on Back)

Records indicate this corner is common with A-1, T2N, R12E; A-13, T3N, R12E; and M-13, T3N, R11E.

B. Description of corner evidence found and/or method applied in restoring or reestablishing corner:

M-1 Found an Oakland County Monument in a monument box at the C/L intersection of South Boulevard (bit.) running West, Hall Road (bit.) running East, and Dequindre Road (bit.) running North and South per L.C.R.C.'s L. 11062 P. 219 and an unrecorded L.C.R.C. by Wilkerson. Checks L.C.R.C.'s L. 04854 P. 207 and a L.C.R.C. - 1994 Macomb County Records. Also checks closely distances as shown in surveys of record.

L.C.R.C. L. 11062 P. 219 (1987)	L.C.R.C. (Macomb County - 1994)
Az. 210° 118.55' PK Nail w/Tag in NW Face of U.P.	S 40° E 88.39' PK & Oakland Co. Remon. Tag in NE Face U.P.
Az 226° 84.27' PK Nail in S Face of U.P. with Light	S 50° W 83.70' PK & Oakland Co. Remon. Tag in N'ly Face U.P.

Unrecorded L.C.R.C. (1993)
S 45° W 84.20' PK W/M-1 Tag SE Face P.P. (m. 84.11')
S 30° W 117.80' PK NW Face U.P. (m. 118.32')

9.00
2.00
FILE ✓

Measure South 3447.56' to M-2 (G.L.O. = 2640.0') (Money = 3447.65')
Measure West 2608.24' to L-1 (G.L.O. = 2640.0')


C. Description of monument for corner and accessories established to perpetuate locating the position of the corner:

M-1 Oakland County Monument in an Existing Monument Box

- PK Nail & Tag Stamped "Oakland Co. Remonumentation P.S. #25854" in NE Side Util. Pole S 40° E 88.40'
- PK Nail & Tag Stamped "Oakland Co. Remonumentation P.S. #25854" in NW Side Util. Pole. S 45° W 83.66'
- PK Nail & Tag Stamped "Oakland Co. Remonumentation P.S. #25854" in NW Side Util. Pole N 35° E 89.40'
- PK Nail & Tag Stamped "Oakland Co. Remonumentation P.S. #25854" in SW Side Util. Pole N 38° W 93.78'
- PK Nail & Tag Stamped "Oakland Co. Remonumentation P.S. #25854" in NW Side Util. Pole S 30° W 118.32'

The selected location is accepted by the Contractor and is generally accepted by professional surveyors as the best available evidence of the position of the original corner.

Signed by Randy Kolehouse Date 5/29/97
EARTH TECH
Surveyor's Michigan License No. 25854

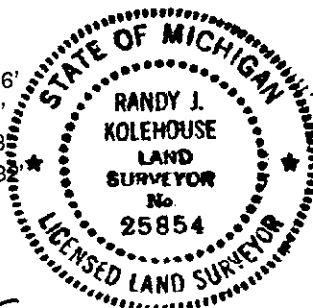

SURVEY &
REMONUMENTATION

LIBER 17277 PG 676

MAR 04 1998

SECTION

PLAT NO. 101-102-103-104-999-1000

A. Description of original monument and accessories and/or subsequent restoration:

M-1	1990	Money	Survey	N/A
	1990	Patterson	L.C.R.C. L. 04854 P. 207 (Macomb Co.)	
	1993	Wilkerson	Unrecorded L.C.R.C.	1" Iron Bar
	1994	Kolehouse	L.C.R.C. L. _____ P. ____ (Macomb Co.)	Macomb Co. Mon. in Mon. Box
	N/A	N/A	O.C. Section Information	N/A
	N/A	N/A	O.C. Tax Maps	N/A

