

**SURVEY & REMONUMENTATION**

JN -9 97 1 2 4 4 5 6

MAR 0 4 1998

LIBER 172770677

**LAND CORNER RECORDATION CERTIFICATE**  
Filing Requirement of Act 74, Mich. P.A. 1970

Compliance with ACT 345, P.A. 1990

**SECTION**

APPROVED ON: 3-26-97 RS  
OAKLAND COUNTY REMONUMENTATION PEER GROUP COMMITTEE

For corners in

	<u>Oakland</u> (County)	Located in:	City of Troy	Corner Code #
1. Public Land Survey		T <u>2N</u>	R <u>11E</u>	<u>M-2</u>
		T _____	R _____	_____
		T _____	R _____	_____
		T _____	R _____	_____
2. Property Controlling in Section	S _____	T _____	R _____	_____
	S _____	T _____	R _____	_____
3. Miscellaneous Property in Sec.	S _____	T _____	R _____	_____
	S _____	T _____	R _____	_____

**\$ 9.00 MISCELLANEOUS RECORDING**  
**\$ 2.00 REMONUMENTATION**  
9 JUN 97 12:18 P.M. RECEIPT# 94A  
PAID RECORDED - OAKLAND COUNTY  
LYNN D. ALLEN, CLERK/REGISTER OF DEEDS

Register of Deeds Stamp & File Number

4. Lot No. \_\_\_\_\_, Recorded Plat \_\_\_\_\_  
5. Private Claims \_\_\_\_\_

	A	B	C	D	E	F	G	H	I	J	K	L	N
2	6		5		4		3		2		1		
3													
4	7		8		9		10		11		12		
5													
6	18		17		16		15		14		13		
7													
8	19		20		21		22		23		24		
9													
10	30		29		28		27		26		25		
11													
12	31		32		33		34		35		36		
13													

I, Randy Kolehouse, in a field survey on March 5 19 97, do hereby certify that under requirements of P.A. 74 Michigan P.A. of 1970, the corner points mentioned in lines 1 and 2 above were in conformance with regulations and rules therefore as required in the current manual of survey instructions of the United States Department of the interior, Bureau of Land Management or by a decree of a Court of Law and/or that the corner points mentioned in lines 3, 4 and 5 above were in conformance with the rules of the Michigan Board of Land Surveyors or by a Decree of a Court of Law; established, re-established, monumented, re-monumented, recovered, found as expressed below:

**NOTE: Not more than 4 corners, all in the same town and range, may be recorded on this certificate.**

**A. Description of original monument and accessories and/or subsequent restoration:**

M-2	1816	Wampler	G.L.O. Notes	Set Post
	1973	Ross	L.C.R.C. L. 7533 P. 837	Fnd. Triangular Iron Bar
	1974	Monohon	Ranieri Sub. L. 142 P. 25	N/A

(Continued on Back)

Records indicate this corner is common with A-2, T2N, R12E.

**B. Description of corner evidence found and/or method applied in restoring or reestablishing corner:**

M-2 Found a PK nail and RJD Tag #21563 on the C/L of Dequindre Road (bit.) running North and South on line of a tree row running East per L.C.R.C.'s L. 11062 P. 219 and L. 04854 P. 207. The found PK nail checks 60.0' East of the West right-of-way line of Dequindre Road per monumentation found in Warwick Woods Sub. (1993) and Ranieri Sub. (1974). Checks closely distances as shown in recorded plats and surveys of record. Also found an iron 4.0' West and 1.0' South of PK and tag. This corner appears to have been used only by S. Money (C.S. L. 11629 P. 330) as no other record of this corner is on file. Held PK and Donnelly tag for M-2.

L.C.R.C. L. 11062 P. 219 (1987)  
Az 27° 166.66' PK Nail w/Tag in NW Face of U.P.  
Az 90° 42.19' PK Nail w/Tag in N Face of U.P.  
Az 180° 180.87' PK Nail w/Tag in W Face of U.P. (m. 180.82')  
Az 335° 95.09' C/L of Fire Hydrant (m. 95.02')

M.C.R.C. File  
East to Pole 42.0'

900 FILE  
200 ✓

Measure North 3446.72' to M-1 (G.L.O. = 2640.0') (Survey L. 11629 P. 330 = 3447.65' to Iron Pipe 1.0' South & 4.0' West of M-2)  
Measure South 2649.91' to M-3 (G.L.O. = 2640.0') (Warwick Woods Sub. = 2649.75')

**C. Description of monument for corner and accessories established to perpetuate locating the position of the corner:**

M-2 Replaced PK nail and tag with a 5/8" x 24" rebar with brass cap stamped "Oakland County Remonumentation P.S. #25854." Also set a new monument box.


PK Nail & Tag Stamped "Oakland Co. Remonumentation P.S. #25854" in NW Face Util. Pole N 20° E 166.66'  
PK Nail & Tag Stamped "Oakland Co. Remonumentation P.S. #25854" in N Face Util. Pole N 90° E 42.19'  
PK Nail & Tag Stamped "Oakland Co. Remonumentation P.S. #25854" in W Face Util. Pole S 10° E 180.82'  
Top Ctr. Nut Hyd. N 25° W 95.02'

The selected location is accepted by the Contractor and is generally accepted by professional surveyors as the best available evidence of the position of the original corner.

Signed by Randy J. Kolehouse Date 5/28/97

EARTH TECH

Surveyor's Michigan License No. 25854

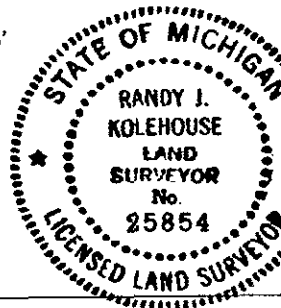

SURVEY &  
REMONUMENTATION

LIBER 17277 PG 678

MAR 04 1998

SECTION

A. Description of original monument and accessories and/or subsequent restoration:

M-2	1976	Patterson	L.C.R.C. L. 2767 P. 835 (Macomb)	N/A
	1987	Donnelly	L.C.R.C. L. 11062 P. 219	PK with Flasher Tag
	1990	Money	Cert. Survey L. 11629 P. 330	N/A
	1990	Patterson	L.C.R.C. L. 04854 P. 207 (Macomb)	Iron
	1993	Patterson	Warwick Woods Sub. L. 223 P. 17	N/A
	N/A	N/A	O.C. Tax Maps	N/A