

MAR 04 1998

LIBER 17277 PG 705

SECTION

LAND CORNER RECORDATION CERTIFICATE
Filing Requirement of Act 74, Mich. P.A. 1970

Compliance with
ACT 345, P.A. 1990


For corners in

| | | | |
|---------------------------------------|--------------------------|-----------------|---------------|
| <u>Oakland</u> (County) | Located in: | City of Troy | Corner Code # |
| 1. Public Land Survey | T <u>2N</u> R <u>11E</u> | | <u>M-4</u> |
| | T _____ R _____ | | _____ |
| | T _____ R _____ | | _____ |
| | T _____ R _____ | | _____ |
| 2. Property Controlling in Section | S _____ T _____ R _____ | | _____ |
| | S _____ T _____ R _____ | | _____ |
| 3. Miscellaneous Property in Sec. | S _____ T _____ R _____ | | _____ |
| | S _____ T _____ R _____ | | _____ |
| 4. Lot No. _____, Recorded Plat _____ | | | |
| 5. Private Claims _____ | | | |

APPROVED ON: 3-26-97
OAKLAND COUNTY REMONUMENTATION
PEER GROUP COMMITTEE

\$ 7.00 MISCELLANEOUS RECORDING
\$ 2.00 REMONUMENTATION
\$ 1.00 REMONUMENTATION
9 JUN 97 12:22 P.M. RECEIPT# 94A
PAID RECORDED - OAKLAND COUNTY
LYN D. GLEN, CLERK/REGISTRAR

I, Randy Kolehouse, in a field survey on March 5 19 97, do hereby certify that under requirements of P.A. 74 Michigan P.A. of 1970, the corner points mentioned in lines 1 and 2 above were in conformance with regulations and rules therefore as required in the current manual of survey instructions of the United States Department of the interior, Bureau of Land Management or by a decree of a Court of Law and/or that the corner points mentioned in lines 3, 4 and 5 above were in conformance with the rules of the Michigan Board of Land Surveyors or by a Decree of a Court of Law; established, re-established, monumented, re-monumented, recovered, found as expressed below:

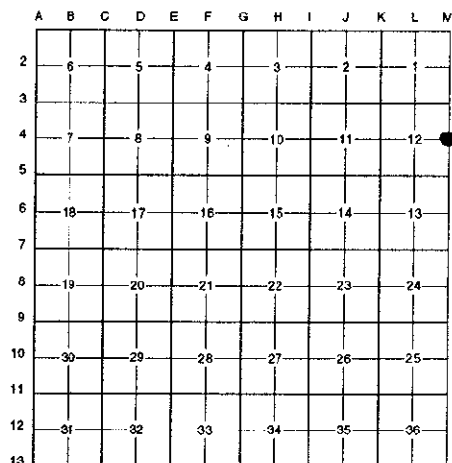

NOTE: Not more than 4 corners, all in the same town and range, may be recorded on this certificate.

A. Description of original monument and accessories and/or subsequent restoration:

| M-4 | 1816 | Wampler | G.L.O. Notes | Set Post |
|-----|------|-----------|----------------------------------|--------------------------------|
| | 1928 | N/A | M.C.R.C. File 40 | Ford Axle in Mon. Box |
| | 1973 | Patterson | L.C.R.C. L. 2380 P. 492 (Macomb) | Iron in Hand Hole |
| | 1977 | Patterson | L.C.R.C. L. 2886 P. 441 (Macomb) | Axle Shaft in Hand Hole |
| | 1988 | Dunn | L.C.R.C. L. 4650 P. 050 (Macomb) | N/A |
| | 1989 | Baily | L.C.R.C. L. 4608 P. 038 (Macomb) | Gear in Mon. Box |
| | 1990 | Fraus | L.C.R.C. L. 11538 P. 038 | Conc. Mon. w/1/2" Iron |
| | 1995 | Kolehouse | L.C.R.C. L. 06779 P. 622 | Axle / Set 5/8" Rebar & MC Cap |

Records indicate this corner is common with A-4, T2N, R12E.

B. Description of corner evidence found and/or method applied in restoring or reestablishing corner:

M-4 Found a 5/8" rebar in a monument box 1.5' West of the C/L of Dequindre Rd. (bit.) running North and South on line of a tree row running West per M.C.R.C. File 40, L.C.R.C.'s L. 11538 P. 038, L. 2886 P. 441 and L. 06779 P. 622. Checks closely distances as shown in the recorded plats.

| | | |
|-----------------------------|---|--|
| M.C.R.C. File 40 | L.C.R.C. L. 11538 P. 038 (1990) | L.C.R.C. L. 2886 P. 441 (Macomb County 1977) |
| N 40° E 68.95' in D.E. Pole | N 40° E 67.87' PK Nail in P.P. (m. 67.89') | NE'y 68.81' PK Nail in U.P. |
| | S 20° W 85.88' PK Nail in 9" Elm Tree (m. 86.10') | SE'y 121.34' Nail & Washer in U.P. |
| | S 70° W 46.60' PK Nail in P.P. (m. 46.62') | SW'y 46.73' Nail & Washer in U.P. |

L.C.R.C. L. 06779 P. 622 (Macomb County 1995)
S 70° W 46.61' Nail & Macomb Co. Remon. Tag in SE Face P.P.
N 50° E 67.90' Nail & Macomb Co. Remon. Tag in NW'y Face P.P.

Measure North 2653.62' to M-3 (G.L.O. = 2640.0') (Forest Brook Sub. (Macomb) = 2653.55'
Measure South 2622.96' to M-5 (G.L.O. = 2640.0') (Amber Pointe Sub. (Macomb) = 2622.95'

C. Description of monument for corner and accessories established to perpetuate locating the position of the corner:

M-4 Replaced 5/8" rebar with a 5/8" x 24" rebar with brass cap stamped "Oakland County Remonumentation P.S. #25854" in an existing monument box.
PK Nail & Tag Stamped "Oakland Co. Remonumentation P.S. #25854" in NW Side Util. Pole N 40° E 67.89'
PK Nail & Tag Stamped "Oakland Co. Remonumentation P.S. #25854" in W Side Util. Pole S 20° E 119.99'
PK Nail & Tag Stamped "Oakland Co. Remonumentation P.S. #25854" in S Side Util. Pole S 70° W 46.62'
PK Nail & Tag Stamped "Oakland Co. Remonumentation P.S. #25854" in E Side 12" Elm S 25° W 86.10'

The selected location is accepted by the Contractor and is generally accepted by professional surveyors as the best available evidence of the position of the original corner.

Signed by Randy Kolehouse
EARTH TECH

Date 5/29/97

Surveyor's Michigan License No. 25854

