

MAR 04 1998

LIBER 1727706706

SECTION

LAND CORNER RECORDATION CERTIFICATE
Filing Requirement of Act 74, Mich. P.A. 1970

Compliance with ACT 345, P.A. 1998


For corners in

Table with columns: Oakland (County), Located in: City of Troy, Corner Code #. Rows include Public Land Survey, Property Controlling in Section, Miscellaneous Property in Sec., Lot No., Private Claims.

APPROVED ON: 5-02-97
OAKLAND COUNTY REMONUMENTATION PEER GROUP COMMITTEE

\$ 7.00 MISCELLANEOUS RECORDING
\$ 2.00 REMONUMENTATION
9 JUN 97 12:23 P.M. RECEIPT# 94A
PAID RECORDED - OAKLAND COUNTY
LYNN D. ALLEN, CLERK/REGISTER OF DEEDS
Register of Deeds Stamp & File Number

I, Randy Kolehouse, in a field survey on March 11 19 97, do hereby certify that under requirements of P.A. 74 Michigan P.A. of 1970, the corner points mentioned in lines 1 and 2 above were in conformance with regulations and rules therefore as required in the current manual of survey instructions of the United States Department of the interior, Bureau of Land Management or by a decree of a Court of Law and/or that the corner points mentioned in lines 3, 4 and 5 above were in conformance with the rules of the Michigan Board of Land Surveyors or by a Decree of a Court of Law; established, re-established, monumented, re-monumented, recovered, found as expressed below:

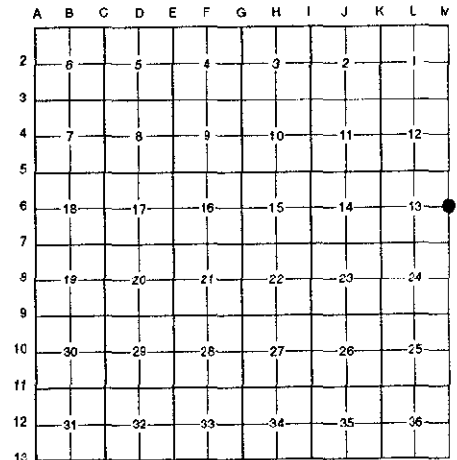

NOTE: Not more than 4 corners, all in the same town and range, may be recorded on this certificate.

A. Description of original monument and accessories and/or subsequent restoration:

Table with columns: M-6, 1816, Wampler, G.L.O. Notes, Set Post. Lists various monuments and their details.

Records indicate this corner is common with A-6, T2N, R12E.

B. Description of corner evidence found and/or method applied in restoring or reestablishing corner:

M-6 Found a Macomb County Monument stamped "Macomb County Monument MI Act 345 #25854" in a monument box at the C/L of Dequinder Road (bit.) running North and South on line of a tree row running East and West per L.C.R.C. L. 06779 P. 624 (Macomb County). Checks closely distances as shown in recorded plats and the Oakland County tax records.

L.C.R.C. L. 2358 P. 932 (1972) NE 67.0' D.E. Pole SE 114.5' D.E. Pole (m. 114.43')
L.C.R.C. L. 06779 P. 624 (1995) N 50° E 67.00' Nail and Macomb Co. Remon. Tag in N Face P.P. S 20° E 114.43' Nail and Macomb Co. Remon. Tag in N Face P.P. N 85° W 55.44' Nail and Macomb Co. Remon. Tag in Bit. at SW Cor. of Drive Ent. 0.5' ± E of Face at Walk NE 246.56' Cor. Brick Bldg. N 70° E 54.32' C/L Hyd. W 65.99' C/L Hyd.


Measure North 2660.2' to M-5 (G.L.O. = 2640.0') (Windmill Pointe Sub. = 2659.5' (Calc.)) (L.C.R.C. L. 06779 P. 624 = 2660.12') Measure South 2644.5' to M-7 (G.L.O. = 2640.0') (Wattles Pointe Sub. = 2645.07') (L.C.R.C. L. 06779 P. 624 = 2644.30')

C. Description of monument for corner and accessories established to perpetuate locating the position of the corner:

M-6 Macomb County Monument in an Existing Monument Box

PK Nail & Tag Stamped "Oakland Co. Remonumentation P.S. #25854" in N Face P. Pole N 50° E 67.00' PK Nail & Tag Stamped "Oakland Co. Remonumentation P.S. #25854" in N Face P. Pole S 20° E 114.43' PK Nail & Tag Stamped "Oakland Co. Remonumentation P.S. #25854" in Bituminous at SW Cor. Drive Ent. 0.5' ± E of Face at Walk S 85° W 55.44' C/L Hydrant N 70° E 54.33' C/L Hydrant N 30° W 66.01'

The selected location is accepted by the Contractor and is generally accepted by professional surveyors as the best available evidence of the position of the original corner.

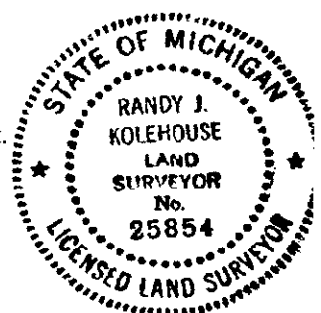

Signed by: Randy J. Kolehouse Date: 5/29/97
EARTH TECH
Surveyor's Michigan License No. 25854