

SURVEY & REMONUMENTATION

LIBER 17055 PG 753

MAR 04 1998 LAND CORNER RECORDATION CERTIFICATE
Filing Requirement of Act 74, Mich. P.A. 1970

For corners in Oakland SECTION Located In: Troy Twp Corner Code #

- 1. Public Land Survey T 2N R 11E M-7
2. Property Controlling in Section S T R
3. Miscellaneous Property in Sec. S T R

APPROVED ON 2-26-97 TS
OAKLAND COUNTY REGISTER OF DEEDS
Register of Deeds Stamp & File Number

4. Lot No. Recorded Plat
5. Private Claims

I, Huston K. Kennedy, in a field survey on 12/12, 1996 hereby state that under requirements of P.A. 74, Michigan P.A. of 1970, the corner points mentioned in lines 1 and 2 above were in conformance with regulations and rules therefore as required in the current manual of survey instructions of the United States Department of the Interior, Bureau of Land Management or by a decree of a Court of Law and/or that the corner points mentioned in lines 3, 4 and 5 above were in conformance with the rules of the Michigan Board of Land Surveyors or by a Decree of a Court of Law; established, re-established, monumented, recovered, found as expressed below:

NOTE: Not more than 2 corners, all in the same town and range, may be recorded on this certificate.

Grid table with columns A-L and rows 1-13. Contains numbers 1-36 in a grid pattern.

- A. Description of original monument and accessories and/or subsequent restoration:
1817-GLO Wampler, D.S.; Set Post 22" Lynn S15°E 1 Link; 6" Lynn S11°W 4 Links
1.) 1995-Kolehouse, PS #25854; LCRC L.6779, Pg.625 - Fnd 5/8" Rebar in a Monument Box (Macomb County)
2.) 1925-Baldwin, PS #1298; Unrecorded Survey, object found not stated, no witnesses

\$ 9.00 MISCELLANEOUS RECORDING
\$ 2.00 REMONUMENTATION
13 MAR 97 11:48 A.M. RECEIPT# 105A
PAID RECORDED - OAKLAND COUNTY
LYNN D. ALLEN, CLERK/REGISTER OF DEEDS

- B. Description of corner evidence found and/or method applied in restoring or reestablishing corner:
1997 Kennedy Surveying, Inc. - Kennedy, PS #17623 - Fnd 3/4" Iron Rod with 2" diameter aluminum cap stamped Macomb County Remonumentation #25854 in a Monument Box in the intersection of Dequindre Road extending to the North & South, which has a bituminous surface and Wattles Road extending to the East & West, which has a bituminous surface. This corner is being used and accepted as a common corner to Sections 18 & 19, T2N, R12E, Sterling Heights (A-7).

Witnesses from LCRC #1, "SUPERVISOR'S PLAT OF FORSYTH ACRES", L.13, Pg.55, and "SUPERVISOR'S PLAT OF BROADACRES SUBDIVISION", L.35, Pg.56 of OCR were used to recover and verify the location of the found 3/4" Iron Rod with 2" diameter aluminum cap stamped Macomb County Remonumentation #25854 in a Monument Box.


I accepted the found 3/4" Iron Rod with 2" diameter aluminum cap stamped Macomb County Remonumentation #25854 in a Monument Box as the best evidence of the original corner position. Field measurements see back side of LCRC

- C. Description of monument for corner and accessories established to perpetuate locating the position of the corner:
M-7 I accepted the found with a 3/4" Iron Rod w/2" diameter aluminum cap stamped Macomb County Remonumentation, PS #17623 in a existing Monument Box.
N25°W 60.84' Fnd Nail & Macomb Remon Washer East face Power Pole
S70°W 64.91' Fnd Nail & Macomb Remon Washer North face Power Pole
S30°E 66.07' Fnd Nail & Macomb Remon Washer North face Power Pole
N60°E 72.44' Fnd Nail & Macomb Remon Washer South face Power Pole

The selected location is accepted by me and is generally accepted by Professional Surveyors as the best available evidence of the position of the original corner.

Signed by [Signature]
Surveyor's Michigan License No. 17623

Date 2-27-97

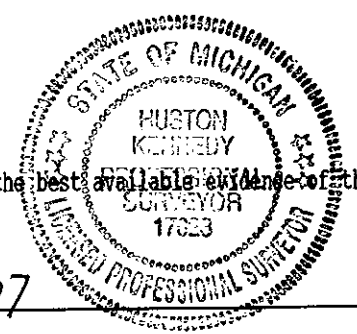

SURVEY &
REMONUMENTATION

MAR 04 1998

SECTION

LIBER 17055 PG 754

FIELD MEASUREMENTS BETWEEN

L-7 to M-7

GLO = 39.22 chains or 2588.52 Ft.
M. Baldwin, PS #1298 (1925) 2606.20 Ft.
"SUPERVISOR'S PLAT OF FORSYTH ACRES", 2606.56 Ft.
"SUPERVISOR'S PLAT OF BROADACRES SUBDIVISION NO. 5", 2606.56 Ft.
"EYSTERS DEQUINDRE FARMS SUBDIVISION NO. 5", 2606.56 Ft.
GPS-HEA 2606.73 Ft.

M-7 to M-8 (M-8, held 1/2" Iron in a Monument Box)

GLO = 40 chains or 2640.00 Ft.
MCS 2646.88 Ft. No date stated
GPS-HEA 2646.62 Ft.