

SURVEY & REMONUMENTATION

LIBER 1715670262

MAR 04 1998

LAND CORNER RECORDATION CERTIFICATE  
Filing Requirement of Act 74, Mich. P.A. 1970

SECTION

For corners in

Oakland  
(County)

Located in: Troy Twp. Corner Code #

- 1. Public Land Survey T 2N R 11E H-9  
T     R          
T     R          
T     R
- 2. Property Controlling in Section S     T     R      
S     T     R
- 3. Miscellaneous Property in Sec. S     T     R      
S     T     R

\$ 9.00 MISCELLANEOUS RECORDING  
\$ 2.00 REMONUMENTATION  
24 APR 97 8:47 A.M. RECEIPT# 55A  
PAID RECORDED - OAKLAND COUNTY  
LYNN D. ALLEN, CLERK/REGISTER OF DEEDS  
Compliance with ACT 345, P.A. 1990  
APPROVED ON: 3-25-97 TS  
OAKLAND COUNTY REMONUMENTATION PEER GROUP COMMITTEE  
Register of Deeds Stamp & File Number

4. Lot No. \_\_\_\_\_, Recorded Plat \_\_\_\_\_  
5. Private Claims \_\_\_\_\_

I, Huston K. Kennedy, in a field survey on 12/29, 1996 do hereby state that under requirements of P.A. 74, Michigan P.A. of 1970, the corner points mentioned in lines 1 and 2 above were in conformance with regulations and rules therefore as required in the current manual of survey instructions of the United States Department of the Interior, Bureau of Land Management or by a decree of a Court of Law and/or that the corner points mentioned in lines 3, 4 and 5 above were in conformance with the rules of the Michigan Board of Land Surveyors or by a Decree of a Court of Law; established, re-established, monumented, recovered, found as expressed below:

NOTE: Not more than 2 corners, all in the same town and range, may be recorded on this certificate.

|    |    |   |    |   |    |   |    |   |    |   |    |   |   |
|----|----|---|----|---|----|---|----|---|----|---|----|---|---|
|    | A  | B | C  | D | E  | F | G  | H | I  | J | K  | L | M |
| 1  |    |   |    |   |    |   |    |   |    |   |    |   |   |
| 2  | 6  |   | 5  |   | 4  |   | 3  |   | 2  |   | 1  |   |   |
| 3  |    |   |    |   |    |   |    |   |    |   |    |   |   |
| 4  | 7  |   | 8  |   | 9  |   | 10 |   | 11 |   | 12 |   |   |
| 5  |    |   |    |   |    |   |    |   |    |   |    |   |   |
| 6  | 18 |   | 17 |   | 16 |   | 15 |   | 14 |   | 13 |   |   |
| 7  |    |   |    |   |    |   |    |   |    |   |    |   |   |
| 8  | 19 |   | 20 |   | 21 |   | 22 |   | 23 |   | 24 |   |   |
| 9  |    |   |    |   |    |   |    |   |    |   |    |   |   |
| 10 | 30 |   | 29 |   | 28 |   | 27 |   | 26 |   | 25 |   |   |
| 11 |    |   |    |   |    |   |    |   |    |   |    |   |   |
| 12 | 31 |   | 32 |   | 33 |   | 34 |   | 35 |   | 36 |   |   |
| 13 |    |   |    |   |    |   |    |   |    |   |    |   |   |

- A. Description of original monument and accessories and/or subsequent restoration:  
1817-GLO Wampler, D.S.; Set Post 7" Ash S01°E 13 Links; 44" Elm N11°W 16 Links  
1.) 1990-Wilkerson, PS #21584; LCRC L.11232, Pg.627 - Fnd 1/2" Iron Rod  
2.) 1991-Marini, PS #26462; LCRC L.12173, Pg.265 - Fnd 1/2" Iron in a Monument Box  
3.) 1987-Griggs, PS #23511; LCRC (Macomb County) L.4131, Pg.655 - Fnd Monument Box  
4.) 1997-Kolehouse, PS #25854; LCRC (Macomb County) L.7298, Pg.261 - Fnd 1/2" Rebar in a Monument Box  
5.) City of Troy Witnesses - Fnd 1/2" Iron Rod (unrecorded)  
6.) 1967-Macomb County Road Commission - Fnd 1/2" solid Iron in a Monument Box (unrecorded)  
7.) 1928-Macomb County Road Commission - Fnd 1/2" Gas Pipe in a standard Monument Box (unrecorded)

B. Description of corner evidence found and/or method applied in restoring or reestablishing corner:  
1997 Kennedy Surveying, Inc. - Kennedy, PS #17623 - Fnd 3/4" Iron Rod with 2" diameter aluminum cap stamped "Macomb County Monument, MI Act #345 #25854 in a existing Monument Box.

Witnesses from LCRC #1, 2, 4, unrecorded City of Troy Witnesses, and State Plane Coordinates were used to recover and verify the location of the found 3/4" Iron Rod with 2" diameter aluminum cap stamped "Macomb County Monument, MI Act #345 #25854 in a existing Monument Box.

I accepted the found 3/4" Iron Rod with 2" diameter aluminum cap stamped "Macomb County Monument, MI Act #345 #25854 in a existing Monument Box as the best evidence of the original corner position.

Field measurements between see back side of LCRC


C. Description of monument for corner and accessories established to perpetuate locating the position of the corner:  
H-9 I found 3/4" Iron Rod with 2" diameter aluminum cap stamped "Macomb County Monument, MI Act #345 #25854 in a existing Monument Box

- S26°E 101.72 Ft. Fnd P.K. Nail in SW face Power Pole
- N28°E 120.73 Ft. Fnd P.K. Nail in sidewalk @ NE corner
- N20°W 138.30 Ft. Fnd P.K. Nail in sidewalk @ SW corner
- N40°E 113.39 Ft. Fnd Center of top of fire hydrant
- S42°W 101.91 Ft. Fnd P.K. & Tag #14864 Power Pole
- N28°W 111.76 Ft. Fnd P.K. & Tag #14864 Power Pole

The selected location is accepted by me and is generally accepted by Professional Surveyors as the best available evidence of the position of the original corner.

Signed by [Signature]  
Surveyor's Michigan License No. 17623

Date 3/20/97

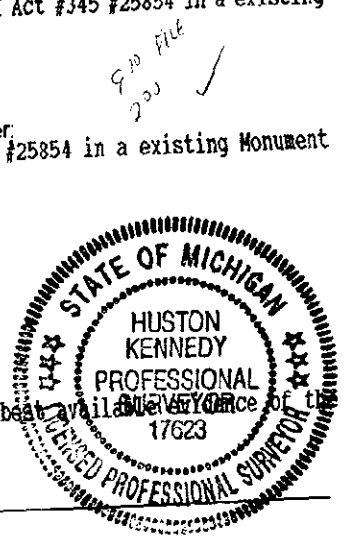

SURVEY &  
REMONUMENTATION

MAR 04 1998

LIBER 17156 PG 263

SECTION

FIELD MEASUREMENTS BETWEEN

M-9 to L-9

GLO = 39.74 chains or 2622.84 Ft.  
M.C.S. = 2646.06 Ft. No date stated  
"BEAVER TRAIL SUBDIVISION" + GOLDEN GATE SQUARE SUBDIVISION" + Parcels = 2646.42 Ft.  
"MOREL EAST SUBDIVISION" = 2646.40 Ft.  
GPS-MEA = 2646.44 Ft.

M-9 to M-8

GLO = 40 chains or 2640.00 Ft.  
M.C.S. = 2639.25 Ft. No date stated  
GPS-MEA = 2641.87 Ft.

M-9 to M-10

GLO = 40 chains or 2640.00 Ft.  
"YORKSHIRE SUBDIVISION" + "EVA HAUS SUBDIVISION" + "CARLSON HEIGHTS SUBDIVISION" = 2356.45 Ft.  
GPS-MEA = 2656.65 Ft.