

SURVEY & REMONUMENTATION

MAR 04 1998

LIBER 17325 PG 335

SECTION

LAND CORNER RECORDATION CERTIFICATE Filing Requirement of Act 74, Mich. P.A. 1970 \$ 9.00 MISCELLANEOUS RECORDING \$ 2.00 REMONUMENTATION

For corners in

Oakland

(County)

Located In: Troy Twp. Corner Code #

- 1. Public Land Survey T 2N R 11E M-13
2. Property Controlling in Section S T R
3. Miscellaneous Property in Sec. S T R

24 JUN 97 3:38 P.M. RECEIPT# 179A PAID RECORDED - OAKLAND COUNTY LYNN D. ALLEN, CLERK/REGISTER OF DEEDS

Compliance with ACT 345, P.A. 1990

APPROVED ON: 6-5-97 TS OAKLAND COUNTY REMONUMENTATION PEER GROUP COMMITTEE

Register of Deeds Stamp & File Number

4. Lot No. Recorded Plat
5. Private Claims

I, Huston K. Kennedy, in a field survey on 5/15, 1997 do hereby state that under requirements of P.A. 74, Michigan P.A. of 1970, the corner points mentioned in lines 1 and 2 above were in conformance with regulations and rules therefore as required in the current manual of survey instructions of the United States Department of the Interior, Bureau of Land Management or by a decree of a Court of Law and/or that the corner points mentioned in lines 3, 4 and 5 above were in conformance with the rules of the Michigan Board of Land Surveyors or by a Decree of a Court of Law; established, re-established, monumented, recovered, found as expressed below:

NOTE: Not more than 2 corners, all in the same town and range, may be recorded on this certificate.

Grid table with columns A-M and rows 1-13. Contains numbers 6 through 36 in a grid pattern.

- A. Description of original monument and accessories and/or subsequent restoration: 1817-GLO Wampler, D.S.; Set Post 5" Ash S14 W 17 Links; 8" Elm N56 E 12 Links
1.) 1990-Wilkerson, PS #21584; LCRC L.11232, Pg.626 - Fnd 1/2" Iron Rod
2.) 1994-Dunn, PS #28404; LCRC L.6527, Pg.864 (Macomb County Records) - Fnd 1/2" Iron in a Monument Box
3.) 1989-Kennitz, PS #16931; Unrecorded Survey - Object found not stated, no witnesses
4.) 1989-Kennitz, PS #16931; Unrecorded Survey - Object found not stated, no witnesses

B. Description of corner evidence found and/or method applied in restoring or reestablishing corner: 1997 Kennedy Surveying, Inc. - Kennedy, PS #17623 - Fnd 3/4" Iron Rod with Macomb County Remonumentation Cap in a Monument Box in the existing centerline of Dequindre Road extending to the North and South, which has a concrete surface, also in the existing centerline of 14 Mile Road extending to the East, which has a concrete surface and to the West, and a bituminous surface to the East.


Witnesses from LCRC #1, 2 and "LEHO INDUSTRIAL ACRES NO. 5" were used to recover and verify the location of the found 3/4" Iron Rod with Macomb County Remonumentation Cap in a Monument Box.

I accepted the found 3/4" Iron Rod with Macomb County Remonumentation Cap in a Monument Box as the best evidence of the original corner position. Field measurements between see back side of LCRC

C. Description of monument for corner and accessories established to perpetuate locating the position of the corner:

- M-13 I accepted the 3/4" Iron Rod with Macomb County Remonumentation Cap in a Monument Box
N45 W 94.79' Center of SE bolt in a concrete base for a traffic pole
N43 E 90.80' Set PK & Remon Washer NW face Power Pole
S45 E 83.83' Set PK & Remon Washer SW face Power Pole
S45 W 121.85' Set PK & Remon Washer SE face Power Pole

The selected location is accepted by me and is generally accepted by Professional Surveyors as the best available evidence of the position of the original corner.

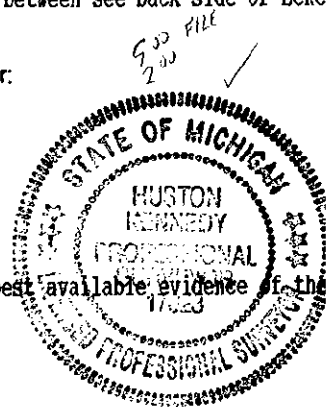

Signed by [Signature]
Surveyor's Michigan License No. 17623

Date 6-6-97

SURVEY &  
REMONUMENTATION

MAR 04 1998

SECTION

LIBER 17325 PG 336

FIELD MEASUREMENTS BETWEEN

W-13 to L-13

GLO = 40 chains or 2640.00 Ft.

Parcels + "INDUSCO SUBDIVISION" + "SUPERVISOR'S PLAT OF COOPER SUBDIVISION" = 2766.85 Ft.

GPS-NEA = 2765.55 Ft.

W-13 to M-1

GLO = 40 chains or 2640.00 Ft.

"LEHO INDUSTRIAL ACRES NO. 4" & No. 5" + Parcels = 2635.42

GPS-NEA = 2835.24 Ft.

W-13 to M-12

GLO = 40 chains or 2640.00 Ft.

"DEQUINDRE ESTATES" + "QUAD CITY INDUSTRIAL PARK SUBDIVISION" + Parcels = 2569.19 Ft.

GPS-NEA = 2667.88 Ft.