


Form 974.

T. 3 N. R. 7 E. Mer.

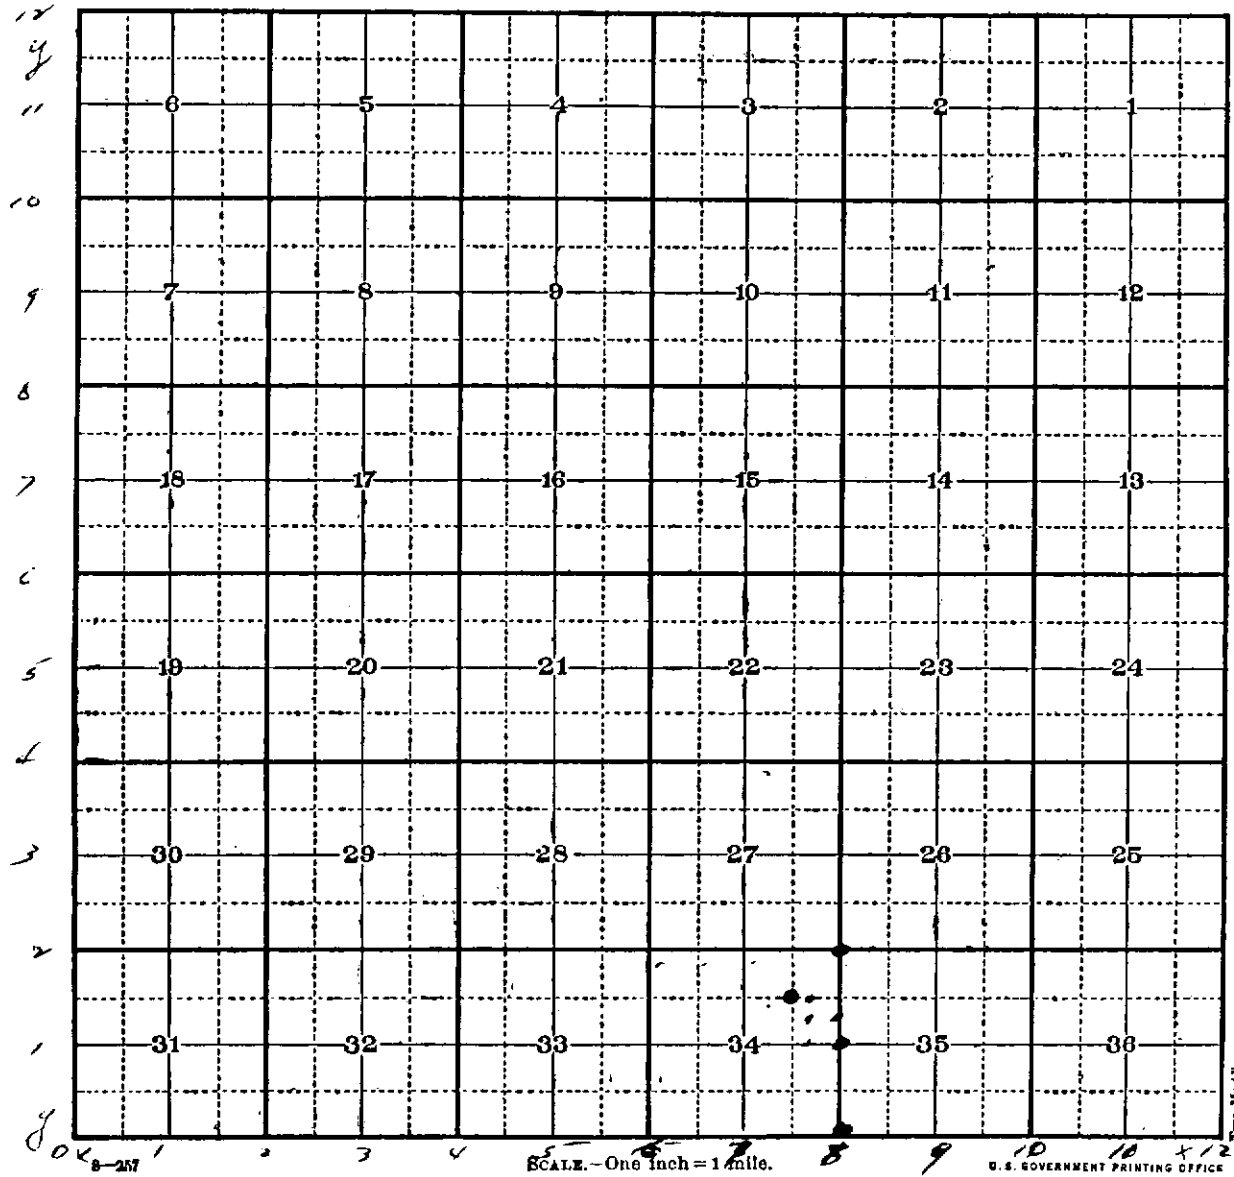

Double Corners