

OAKLAND COUNTY  
ROAD COMMISSION

REFERENCE  
NO. 149

# SECTION CORNER TIES

T. 3 N., R. 7 E.

DATE: JULY-13-1962

HIGHLAND TOWNSHIP

DESCRIPTION OF CORNER E 1/4 COR SEC 34, W 1/4 COR SEC 35


CORNER MONUMENT END 3/4" X 30" PIPE

DATE MONUMENT PLACE AND WITNESSED 1957

WITNESSES TO CORNER SE 48.66 SPK 14" B OAK

S 21' E REID RD

E 43.79 SPK IN 48" WHITE WOOD

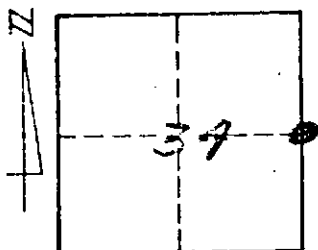

ADDITIONAL INFORMATION AND DESCRIPTION

-----  
-----  
-----  
-----  
-----  
-----

5