

OAKLAND COUNTY  
ROAD COMMISSION

REFERENCE  
NO. 16A

# SECTION CORNER TIES

T. 3 N., R. 7 E.

DATE: JULY-13-1962


HIGHLAND TOWNSHIP

DESCRIPTION OF CORNER SE COR SEC 33, SW COR SEC 34

CORNER MONUMENT STONE WITH IRON PIPE ON TOP

DATE MONUMENT PLACE AND WITNESSED 5-20-1935

WITNESSES TO CORNER S 45.80 COR FE. POST

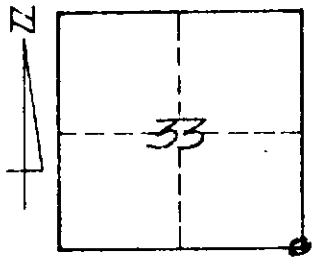

SW 71.75 10" W. C.A.K

ADDITIONAL INFORMATION AND DESCRIPTION

