

OAKLAND COUNTY  
ROAD COMMISSION

REFERENCE  
NO. 166

# SECTION CORNER TIES

T. 3 N. , R. 7 E.


DATE: JULY-13-1962 HIGHLAND TOWNSHIP

DESCRIPTION OF CORNER SE COR SEC 34 SW COR SEC 35

CORNER MONUMENT 1" IRON PIPE WITH BRASS SECTION COR. CAP.

DATE MONUMENT PLACE AND WITNESSED 1957

WITNESSES TO CORNER \_\_\_\_\_

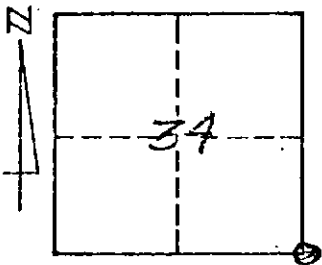

ADDITIONAL INFORMATION AND DESCRIPTION \_\_\_\_\_

1" IRON PIPE WITH BRASS SECTION COR. CAP. SET. IN  
STONE PILE BY W.H. PADDSUN (M.S.C.D.)

I-13