

LAND CORNER RECORDATION CERTIFICATE
Filing Requirement of Act 74, Mich. P.A. 1970

51116

For corners in

Oakland
(County)

Located in: Highland Township Corner Code #

LIDER 21118 PAGE 108
\$9.00 MISC RECORDING
\$2.00 RE-MONUMENTATION
02/18/2000 10:02:34 A.M. RECEIPT# 13978
PAID RECORDED - OAKLAND COUNTY
G. WILLIAM CADDELL, CLERK/REGISTER OF DEEDS

1. Public Land Survey

T3N R7E A-6

2. Property Controlling in Section

S T R SURVEY & RE-MONUMENTATION

3. Miscellaneous Property in Sec.

S T R MAR 21 2000

4. Lot No. _____ Recorded Plat _____ SECTION _____

5. Private Claims _____

Compliance with ACT 345, P.A. 1990

PROVED ON: 11-2-99 JK
OAKLAND COUNTY COMMUNISTATIC
DEED GROUP 4, 11/2/1999

Register of Deeds Stamp & File Number

| | A | B | C | D | E | F | G | H | I | J | K | L | M |
|----|----|---|----|---|----|---|----|---|----|---|----|---|---|
| 1 | | | | | | | | | | | | | |
| 2 | 6 | | 5 | | 4 | | 3 | | 2 | | 1 | | |
| 3 | | | | | | | | | | | | | |
| 4 | 7 | | 8 | | 9 | | 10 | | 11 | | 12 | | |
| 5 | | | | | | | | | | | | | |
| 6 | 18 | | 17 | | 16 | | 15 | | 14 | | 13 | | |
| 7 | | | | | | | | | | | | | |
| 8 | 19 | | 20 | | 21 | | 22 | | 23 | | 24 | | |
| 9 | | | | | | | | | | | | | |
| 10 | 30 | | 29 | | 28 | | 27 | | 26 | | 25 | | |
| 11 | | | | | | | | | | | | | |
| 12 | 31 | | 32 | | 33 | | 34 | | 35 | | 36 | | |
| 13 | | | | | | | | | | | | | |

I, Huston K. Kennedy, in a field survey on April 15, 1999 do hereby state that under requirements of P.A. 74, Michigan P.A. of 1970, the corner points mentioned in lines 1 and 2 above were in conformance with regulations and rules therefore as required in the current manual of survey instructions of the United States Department of the Interior, Bureau of Land Management or by a decree of a Court of Law and/or that the corner points mentioned in lines 3, 4 and 5 above were in conformance with the rules of the Michigan Board of Land Surveyors or by a Decree of a Court of Law, established, re-established, monumented, recovered, found as expressed below.

NOTE: Not more than 2 corners, all in the same town and range, may be recorded on this certificate.

A. Description of original monument and accessories and/or subsequent restoration:

- 1817-GLO Wampler, D.S.; No post was set, no witnesses
- 1.) 1995-Smith, PS #35999; LCRC for (Livingston Cty) L.S.C. #504m - Fnd a 1/2" Iron Rod
- 2.) 1956-Oakland County Road Commission Section Corner Ties - Set a "T" Iron

B. Description of corner evidence found and/or method applied in restoring or reestablishing corner:

1999-Kennedy Surveying, Inc. - Kennedy, PS #17823 - Fnd a 1-1/4" Iron Pipe w/2" diameter brass cap stamped "Livingston County Monument Corner, PS #35999" in the existing centerline of Tipsico Lake Road extending to the North with a grave surface, and extending to the South with a bituminous surface. A tree-fence row extending to the East & West. This corner is being used and accepted as a common corner with the East 1/4 corner of Section 13, T3N, R6E, Hartland Township (M-6).

Witnesses from LCRC #1 were used to recover and verify the location of the found 1-1/4" iron Pipe w/2" diameter brass cap stamped "Livingston County Monument Corner, PS #35999".

I accepted the found 1-1/4" Iron Pipe w/2" diameter brass cap stamped "Livingston County Monument Corner, PS #35999 as the best evidence of the original corner position.

FIELD MEASUREMENTS BETWEEN

A-6 to A-5

No GLO


Sidwell W 1/2 Sec 18 (11-18) = 2631.19 Ft.

Unrecorded Survey by Matthew A. Brady, PS #32333 dated 5/3/91 = 2621.07 Ft.

Unrecorded Survey by John D. Albright, PS #10057 dated 5/13/71 = 2631.19 Ft.

2629.69 Ft. (GPS-MEA)

2p
R

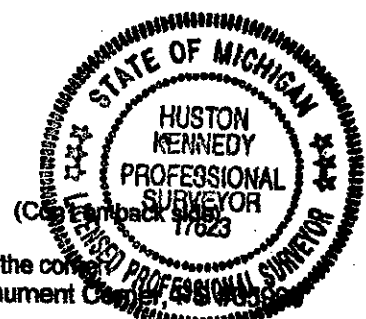

C. Description of monument for corner and accessories established to perpetuate locating the position of the corner:
A-6 I accepted the 1-1/4" Iron Pipe w/2" diameter brass cap stamped "Livingston County Monument Corner, PS #35999"
Due East 41.05' Set Mag Nail & Remon Washer North face 24" Oak
N40°E 54.20' Set Mag Nail & Remon Washer NW face 10" Popolar
S87°W 31.94' Set Mag Nail & Remon Washer South face Power Pole
S39°E 53.15' Set Mag Nail & Remon Washer SW face 12" Oak

The selected location is accepted by me and is generally accepted by Professional Surveyors as the best available evidence of the position of the original corner.

Signed by: [Signature] Date 2-10-00

Surveyor's Michigan License No. 17623

LIBER 21118 109

A-6 to A-7

No GLO, corner falls in a lake

'DUNHAM LAKE ESTATES NO. 1' + Parcels (Sec 18) = 2660.78 Ft.

2628.02 Ft. (Back side of LCRC recorded L.S.C. #523M in Livingston County Records (M-7)

~~1927.85 Ft. (M-6 to reference corner to M-7)~~

~~2679.80 Ft. (GPS CAL)~~

SURVEY &
RE-ORIENTATION

MAR 21 2000

SECTION