

**SURVEY & REMONUMENTATION**

MAY 24 2000

LIBER 19872PC094

SECTION

**LAND CORNER RECORDATION CERTIFICATE**  
Filing Requirement of Act 74, Mich. P.A. 1970

139684

For corners in

Oakland  
(County)

Located in:  
Highland Township

Corner Code #

1. Public Land Survey

T3N	R7E	C-3
T	R	
T	R	
T	R	
S	T	R
S	T	R
S	T	R
S	T	R

2. Property Controlling in Section

3. Miscellaneous Property in Sec.

4. Lot No. \_\_\_\_\_ Recorded Plat \_\_\_\_\_  
5. Private Claims \_\_\_\_\_

LIBER 19872 PAGE 94  
\$9.00 MISC RECORDING  
\$2.00 REMONUMENTATION  
04/22/1999 07:54:39 A.M. RECEIPT# 22152  
PAID RECORDED - OAKLAND COUNTY  
G. WILLIAM CADDELL, CLERK/REGISTER OF DEEDS


Compliance with  
ACT 345, P.A. 1990

APPROVED ON: 4-15-99 JS  
OAKLAND COUNTY REMONUMENTATION  
PEER GROUP COMMITTEE

Register of Deeds Stamp & File Number

I, Huston K. Kennedy, in a field survey on April 2, 1999 do hereby state that under requirements of P.A. 74, Michigan P.A. of 1970, the corner points mentioned in lines 1 and 2 above were in conformance with regulations and rules therefore as required in the current manual of survey instructions of the United States Department of the Interior, Bureau of Land Management or by a decree of a Court of Law and/or that the corner points mentioned in lines 3, 4 and 5 above were in conformance with the rules of the Michigan Board of Land Surveyors or by a Decree of a Court of Law; established, re-established, monumented, recovered, found as expressed below:

NOTE: Not more than 2 corners, all in the same town and range, may be recorded on this certificate.

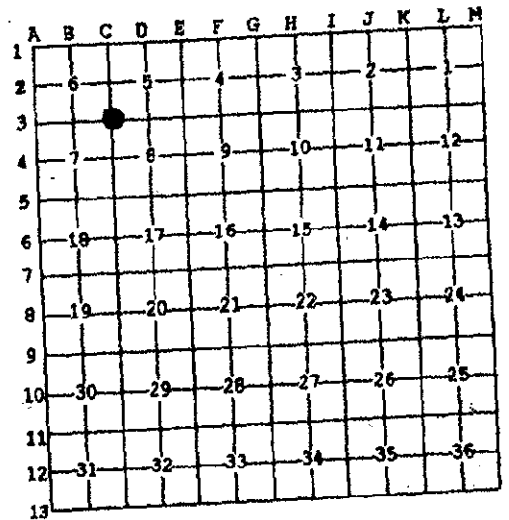

- A. Description of original monument and accessories and/or subsequent restoration:  
1823-GLO Wampler, D.S.; Set Post 24" White Oak S26 1/2°W 72 Links; 23" WhiteOak S10°E 18 Links
- 1.) 1978-Albright, PS #10057; LCRC L.6002, Pg.510 - Fnd a 1/2" Re-rod
  - 2.) 1976-Feldhauser, PS #10685; Survey L.7136, Pg.62 - Object found not stated, no witnesses
  - 3.) 1976-Albright, PS #10057; Unrecorded Survey - Fnd 1/2" Re-rod, used same wit as 1978 LCRC
  - 4.) 1978-Ross, PS #19005; Unrecorded Survey - Fnd a 1/2" Re-rod in a hand hole
  - 5.) 1978-Ross, PS #19005; Unrecorded Survey - Object found not stated, no witnesses
  - 6.) 1980-Smith, PS #21582; Unrecorded Survey - Fnd a Monument, used same wit as 1978 LCRC
  - 7.) 1983-Smith, PS #21582; Unrecorded Survey - Fnd 1/2" Re-rod, used same wit as 1978 LCRC
  - 8.) 1987-Smith, PS #23518; Unrecorded Survey - Fnd 1/2" Re-rod in a Monument Box
  - 9.) 1987-Smith, PS #23518; Unrecorded Survey - Fnd 1/2" Re-rod in a Monument Box, used same wit as 1987 Survey
  - 10.) 1987-Scharf, PS #19843; Unrecorded Survey - Fnd 1/2" Rod, used same wit as 1978 LCRC

B. Description of corner evidence found and/or method applied in restoring or reestablishing corner:  
1999-Kennedy Surveying, Inc. - Kennedy, PS #17623 - Fnd a 1/2" Iron Rod in a Monument Box located in the existing centerline of Clyde Road, which extends to the East & West, which has a gravel surface, also 16 feet West of the existing centerline of North Hickory Ridge Road extending to the North & South which has a bituminous surface.

Witnesses from LCRC #1 and existing monumentation were used to recover and verify the location of the found 1/2" Iron Rod in a Monument Box.

I accepted the found 1/2" Iron Rod in a Monument Box as the best evidence of the original corner position

Field measurements back side of LCRC

- C. Description of monument for corner and accessories established to perpetuate locating the position of the corner:  
C-3 I replaced the found 1/2" Iron Rod with a 5/8" x 24" Iron Rod w/2" diameter brass cap stamped Oakland County Remonumentation, PS #17623 in an existing Monument Box  
N71°W 94.21' Set Mag Nail & Remon Washer SW face Power Pole  
S40°W 49.71' Set Mag Nail & Remon Washer NW face Power Pole  
S42°E 85.47' Set Mag Nail & Remon Washer SW face Power Pole  
N69°E 74.58' Set Mag Nail & Remon Washer SE face Power Pole

The selected location is accepted by me and is generally accepted by Professional Surveyors as the best available evidence the position of the original corner.

Signed by: [Signature]  
Surveyor's Michigan License No. 17623

Date 4-15-99

