

LAND CORNER RECORDATION CERTIFICATE
Filing Requirement of Act 74, Mich. P.A. 1970

For corners in

Oakland (County)

Located In: Highland Township

Corner Code #

273051

LIBER 20329 PAGE 86
\$7.00 MISC RECORDING
\$2.00 REMONUMENTATION
07/29/1999 11:41:06 A.M. RECEIPT# 58913
PAID RECORDED - OAKLAND COUNTY
G. WILLIAM CADDELL, CLERK/REGISTER OF DEED

Compliance with ACT 345, P.A. 1990

APPROVED ON: 4-27-99 JIK
OAKLAND COUNTY REMONUMENTATION PEER GROUP COMMITTEE

Register of Deeds Stamp & File Number

1. Public Land Survey

T3N R7E F-1

2. Property Controlling in Section

T R SURVEY & MONUMENTATION

3. Miscellaneous Property in Sec.

S T R MAR 21 2000

SECTION

4. Lot No. Recorded Plat

5. Private Claims

I, Huston K. Kennedy, in a field survey on January, 1999 do hereby state that under requirements of P.A. 74, Michigan P.A. of 1970, the corner points mentioned in lines 1 and 2 above were in conformance with regulations and rules therefore as required in the current manual of survey instructions of the United States Department of the Interior, Bureau of Land Management or by a decree of a Court of Law and/or that the corner points mentioned in lines 3, 4 and 5 above were in conformance with the rules of the Michigan Board of Land Surveyors or by a Decree of a Court of Law; established, re-established, monumented, recovered, found as expressed below:

NOTE: Not more than 2 corners, all in the same town and range, may be recorded on this certificate.

Grid table with columns A-L and rows 1-13. A dot is marked at the intersection of column F and row 1.

A. Description of original monument and accessories and/or subsequent restoration: 1823-GLO Wampler, D.S.; No post was set, no witnesses

B. Description of corner evidence found and/or method applied in restoring or reestablishing corner: 1999-Kennedy Surveying, Inc. - Kennedy, PS #17623 - This corner was not set during the original government survey. The corner has been perpetuated in two (2) different locations in which I did not accept either location. The corners as found did not verify the distance from F-1 to E-1 and F-1 to G-1 as per the sidwell maps, also monumentation was found at the Northwest corner of Parcel 11-04-100-010, and the Northeast corner of Parcel 11-04-226-004 and the Northwest corner of Parcel 11-04-226-002.

After a discussion with the peer group the decision was made to set that the corner (F-1) at the distance as shown on the sidwell map for E 1/2 Sec 4 (11-4) on the line between E-13 & F-13.

The corner as set does verify the location of the Northeast corner of Parcel 11-04-226-004 and Northwest corner of Parcel 11-04-226-002, but does not verify the location of the monumentation found at the Northwest corner of Parcel 11-04-100-010 by 2.68 feet and a 2.21 feet difference than the distance shown on sidwell W 1/2 Sec 4 (11-4), between F-1 to E-1.

FIELD MEASUREMENTS BETWEEN

F-1 to E-1

No GLO
Sidwell (W 1/2 Sec 4) 11-4 = 2722.56 Ft.
2720.34 Ft. (GPS-MEA)

F-1 to F-13


No GLO
123.95 Ft. (m)

F-1 to G-1

No GLO (G-1 fallen)
Sidwell E 1/2 Sec 4 (11-4) = 2677.33 Ft.
2674.33 Ft. (GPS-MEA)

C. Description of monument for corner and accessories established to perpetuate locating the position of the corner: F-1 I set a 4" diameter Concrete Monument w/1/2" Iron Rod 36" long w/2" diameter brass cap stamped Remonumentation, PS #17623
S75°W 11.40' Set Mag Nail & Remon Washer North face 23" Cherry
S27°E 7.68' Set Mag Nail & Remon Washer West face 18" triple Cherry
Due East 22.85' Set Mag Nail & Remon Washer South face 19" Cherry
N43°E 5.85' Set Mag Nail & Remon Washer NW face 11" Cherry
East 123.95' South 1/4 corner of Section 33, T4N, R7E, Rose Township (F-13)

Due East 8.28' Fnd
Due West 3.85' Fnd

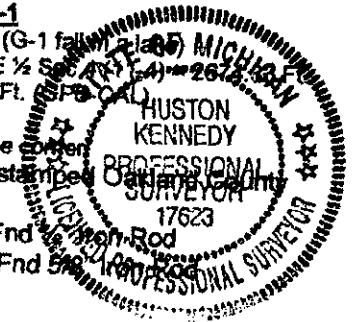

The selected location is accepted by me and is generally accepted by Professional Surveyors as the best available evidence the position of the original corner.

Signed by: [Signature]

Date 4-30-99

Surveyor's Michigan License No. 17623